MAR 1 6 1994

COMMISSION

ALLEGAN COUNTY REMONUMENTATION
LAND CORNER RECORDATION CERTIFICATE
Filing Requirement of Act 74, Mich. P.A. 1970

For corners in Allegan (County)

	Located In:	Corner Code #
1. Public Land Survey	T 3N R 14W	I-7
	T ___ R ___	Sec. 14, 15,
	T ___ R ___	22, 23 Cor.
	T ___ R ___	Heath Twp.
2. Property Controlling	S ___ T ___ R ___	
in Section	S ___ T ___ R ___	
3. Miscellaneous	S ___ T ___ R ___	
Property in Sec.	S ___ T ___ R ___	

FILED
1993 DEC 30 PM 2:44
REGISTER OF DEEDS
ALLEGAN COUNTY, MICH

Register of Deeds Stamp & File Number

4. Lot No. _____ , Recorded Plat _____
5. Private Claims _____

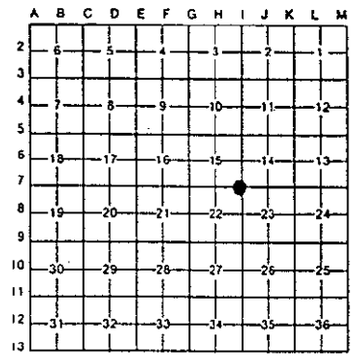

I, Kirk VanOrder, in a field survey on December 13, 19 93, do hereby certify that under requirements of P.A. 74, Michigan P.A. of 1970, the corner points mentioned in lines 1 and 2 above were in conformance with regulations and rules therefore as required in the current manual of survey instructions of the United States Department of the Interior, Bureau of Land Management or by a decree of a Court of Law and/or that the corner points mentioned in lines 3, 4 and 5 above were in conformance with the rules of the Michigan Board of Land Surveyors or by a Decree of a Court of Law; established, re-established, monumented, re-monumented, recovered, found as expressed below:

NOTE: Not more than 4 corners, all in the same town and range, may be recorded on this certificate.

A. Description of original monument and accessories and/or subsequent restoration:

I-7
•GLO set post @ 80.00 chains North of I-9.
9" Pine S83½°E 26 links
10" Pine N82¾°W 41 links
.Hicks survey 1873, no corner noted
•MacDougall survey (no date) noted corner with witnesses
10" B. Oak S 5.2'
12" W. Oak SE 22.4'
•LCRC (L.3, P.291 & 337) 4-2-1980
2" iron pipe
4" W. Oak S36°E 24.90'
8" Quad Oak S45°W 20.10'
10" R. Oak N07°W 21.75'
5" W. Oak E 31.25'
•H.E.I. notes reflect LCRC witnesses

B. Description of corner evidence found and/or method applied in restoring or reestablishing corner:

I-7
Fd. 2" iron pipe
Nail & plastic cap in SW side 6" W. Oak S36°E 24.90'
Nail & plastic cap in S side 10" Quad. Oak S45°W 20.08'
Nail & plastic cap in NW side 13"R. Oak N07°W 21.75'
Nail & plastic cap in S side 9" W. Oak E 31.25'
(Trees have blaze marks)

Accepted as a careful and faithful perpetuation of the position of the original corner.

C. Description of monument for corner and accessories established to perpetuate locating the position of the corner:

I-7
Set standard Allegan Co. monument (3/4" x 30" steel rod with red plastic cap) inside of Fd. 2" pipe approximately 0.4' above ground.
Nail & Allegan Co. Remon. tag in SW side 6" W. Oak S36°E 25.06'
Nail & Allegan Co. Remon. tag in S side 10" Quad. Oak S45°W 20.03'
Nail & Allegan Co. Remon. tag in NW side 13" R. Oak N07°W 21.72'
Nail & Allegan Co. Remon. tag in S side 9" W. Oak E 31.25'
C/L 2-track road S 67'+/-

Signed by _____ Date 12-30-93

STATE OF MICHIGAN
KIRK L. VAN ORDER
LAND SURVEYOR
No. 23520
REGISTERED LAND SURVEYOR

Surveyor's Michigan License No. 23520

LIBER 004 PAGE 331

FORM APPROVED BY MICHIGAN STATE BOARD OF LAND SURVEYORS, JAN. 28, 1971
REVISED MAY 14, 1975
REVISED JAN., 1983