

APR 29 1999

SECTION

ALLEGAN COUNTY REMONUMENTATION
LAND CORNER RECORDATION CERTIFICATE
Filing Requirement of Act 74, Mich. P.A. 1970

For corners in

Allegan (County)	Located in:	Corner Code #
1. Public Land Survey	T <u>3N</u> R <u>14W</u>	<u>K-1</u>
	T <u> </u> R <u> </u>	<u>Heath Twp.</u>
	T <u> </u> R <u> </u>	
	T <u> </u> R <u> </u>	
2. Property Controlling in Section	S <u> </u> T <u> </u> R <u> </u>	
	S <u> </u> T <u> </u> R <u> </u>	
3. Miscellaneous Property in Sec.	S <u> </u> T <u> </u> R <u> </u>	
	S <u> </u> T <u> </u> R <u> </u>	

FILED

1/28/1999 2:44:39 PM

JOYCE A. WATTS
REGISTER OF DEEDS
ALLEGAN COUNTY, MICH

Register of Deeds Stamp & File Number

LIBERO 006 PAGE 4, 5

4. Lot No. _____, Recorded Plat _____
5. Private Claims _____

I, Kirk L. Van Order, in a field survey on July 7, 1998 do hereby state that under requirements of P.A. 74, Michigan P.A. of 1970, the corner points mentioned in lines 1 and 2 above were in conformance with regulations and rules therefore as required in the current manual of survey instructions of the United States Department of the Interior, Bureau of Land Management or by a decree of a Court of Law and/or that the corner points mentioned in lines 3, 4 and 5 above were in conformance with the rules of the Michigan Board of Land Surveyors or by a Decree of a Court of Law, established, re-established, monumented, recovered, found as expressed below:

NOTE: Not more than 2 corners, all in the same town and range, may be recorded on this certificate.

1	A	B	C	D	E	F	G	H	I	J	K	L	M
2		6		5		4		3		2		1	
3													
4		7		8		9		10		11		12	
5													
6		10		17		16		15		14		13	
7													
8		19		20		21		22		23		24	
9													
10		30		29		28		27		26		25	
11													
12		31		32		33		34		35		36	
13													

A. Description of original monument and accessories and/or subsequent restoration:

- K-1
(1) GLO
North between Sections 1 & 2
79.04 chains to N. boundary
62 links West of from where set post: corner Section 1 & 2
W. oak 16" dia. S40°E 15 links
Pine 10" dia. S70°W 49 links
- (2) Hugh MacDougall Sec. 35, T.4N., R.14W. survey notes show stone for Heath corner 41.5' West of SE corner Sec. 35. Early 1900's.
(continued on back of sheet)

B. Description of corner evidence found and/or method applied in restoring or reestablishing corner:


K-1
Fd. 0.95' long star chisel above large stone 1.5'+/- x 1.7'+/- x 1'+/- in size 1.5' below grade.
Set standard Allegan Co. monumnet on town line AZ 270°-00'-00" 41.50' from K-13, T.4N., R.14W. and AZ 90°-00'-00" 2597.405' from J-13, T.4N., R.14W.
Star chisel (removed) was AZ 04°-19'-35" 0.585' from K-1 and center of large stone is AZ 341°-26'07" 0.77' from K-1 as set, and is accepted as a careful and faithful perpetuation of the position of the original corner.
Peer group approved July 14, 1998.

C. Description of monument for corner and accessories established to perpetuate locating the position of the corner:

K-1
Set standard Allegan Co. Remon. monument (3/4" x 36" steel rod w/red cap #23520 and grouted around same with concrete)
Nail & Remon. tag in S side 36" white oak AZ 285°-57' 98.92'
Nail & Remon. tag in S side power pole AZ 99°-26' 154.18'
Nail & Remon. tag in N side power pole AZ 255°-24' 114.04'
NW cor. conc. fndn. of entry old school hse. AZ 150°-58' 148.51'
J-13, T.4N., R.14W. AZ 270°-00' 2597.405'
K-13, T.4N., R.14W. AZ 90°-00' 41.50'

Signed by [Signature]
Surveyor's Michigan License No. 23520

Date 12-23-98

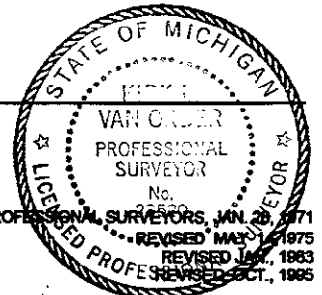

APPROVED REMONUMENTATION CORNER
P.A. 345 OF 1990
ALLEGAN COUNTY
DATE APPROVED July 14, 1998
COUNTY REP. [Signature]

APR 29 1988

SECTION

LIBER 006 PAGE 46

Section A (continued from Page 1)K-1Heath Twp., T.3N., R.14W.

- (3) LCRC by George J. Mitchell, Liber 02, Page 117, dated Feb. 20, 1973
Set R.R. spike on Twp. line at off distance from SE cor. Sec. 35,
T.4N., R.14W.
- | | | |
|-----------------|-------|--------|
| Gas vent pipe | S30°E | 67.50' |
| St. sign | North | 35.45' |
| Tele. cable box | S20°W | 61.70' |
| SE cor. Sec. 35 | East | 41.50' |
- (4) Kirk L. Van Order survey dated June 27, 1985
Fd. R.R. spike and set capped iron in its place
- | | | |
|--------------------|----|--------|
| Wood post | SW | 61.60' |
| 21" weeping willow | SE | 83.85' |
| 10" pine | NW | 48.51' |
| Gas marker | NE | 88.6' |
- (5) Kirk L. Van Order recorded survey, Liber 1243, Page 12, dated May 12, 1987
Fd. re-rod
(same wit. ties as in No. 4)
- (6) Holland Engineering, Inc. corner info.
R.R. spike
(same info. as in No. 3)