

APR 29 1999

SECTION

ALLEGAN COUNTY REMONUMENTATION  
LAND CORNER RECORDATION CERTIFICATE  
Filing Requirement of Act 74, Mich. P.A. 1970

For corners in

| Allegan<br>(County)                   | Located In: | Corner Code # |
|---------------------------------------|-------------|---------------|
| 1. Public Land Survey                 | T 3N R 14W  | L-1           |
|                                       | T R         | Heath Twp.    |
|                                       | T R         |               |
|                                       | T R         |               |
| 2. Property Controlling<br>in Section | S T R       |               |
|                                       | S T R       |               |
| 3. Miscellaneous<br>Property in Sec.  | S T R       |               |
|                                       | S T R       |               |

FILED  
1/28/1999 2:44:39 PM  
JOYCE A. WATTS  
REGISTER OF DEEDS  
ALLEGAN COUNTY, MICH  
Register of Deeds Stamp & File Number

LIBR00006 PAGE 47

4. Lot No. \_\_\_\_\_, Recorded Plat \_\_\_\_\_  
5. Private Claims \_\_\_\_\_

I, Kirk L. Van Order, in a field survey on July 7, 1998 do hereby state that under requirements of P.A. 74, Michigan P.A. of 1970, the corner points mentioned in lines 1 and 2 above were in conformance with regulations and rules therefore as required in the current manual of survey instructions of the United States Department of the Interior, Bureau of Land Management or by a decree of a Court of Law and/or that the corner points mentioned in lines 3, 4 and 5 above were in conformance with the rules of the Michigan Board of Land Surveyors or by a Decree of a Court of Law; established, re-established, monumented, recovered, found as expressed below:

NOTE: Not more than 2 corners, all in the same town and range, may be recorded on this certificate.

|    |    |   |    |   |    |   |    |   |    |   |    |   |   |
|----|----|---|----|---|----|---|----|---|----|---|----|---|---|
| 1  | A  | B | C  | D | E  | F | G  | H | I  | J | K  | L | M |
| 2  | 6  |   | 5  |   | 4  |   | 3  |   | 2  |   | 1  |   |   |
| 3  |    |   |    |   |    |   |    |   |    |   |    |   |   |
| 4  | 7  |   | 8  |   | 9  |   | 10 |   | 11 |   | 12 |   |   |
| 5  |    |   |    |   |    |   |    |   |    |   |    |   |   |
| 6  | 18 |   | 17 |   | 16 |   | 15 |   | 14 |   | 13 |   |   |
| 7  |    |   |    |   |    |   |    |   |    |   |    |   |   |
| 8  | 19 |   | 20 |   | 21 |   | 22 |   | 23 |   | 24 |   |   |
| 9  |    |   |    |   |    |   |    |   |    |   |    |   |   |
| 10 | 30 |   | 29 |   | 28 |   | 27 |   | 26 |   | 25 |   |   |
| 11 |    |   |    |   |    |   |    |   |    |   |    |   |   |
| 12 | 31 |   | 32 |   | 33 |   | 34 |   | 35 |   | 36 |   |   |
| 13 |    |   |    |   |    |   |    |   |    |   |    |   |   |

A. Description of original monument and accessories and/or subsequent restoration:

- L-1  
(1) Not set by GLO  
(2) D.A. Ratekin Assoc. section corner info. card  
N. 1/4 post, Section 1, Heath Twp.  
Hick NE 71.0'  
Hick NE 53.0'  
14" Hick NW 45.3'  
14" B. Ash NE 29.5'  
2659.4' to NE cor. Sec. 1

APPROVED REMONUMENTATION CORNER  
P.A. 345 OF 1990  
ALLEGAN COUNTY  
DATE APPROVED JULY 14, 1998  
COUNTY REP. [Signature]

(continued on back of sheet)

B. Description of corner evidence found and/or method applied in restoring or reestablishing corner:


- Fd. R.R. spike and following accessories as listed in No. 3:  
Set standard Allegan County Monument on townline between M-1, T.3N., R.14W. and K-13, T.4N., R.14W. and midway between M-1, T.3N., R.14W. and K-1, T.3N., R.14W. This position not established by original government surveyors. This monument is accepted as the best available evidence of the position of the corner.  
Fd. R.R. spike (removed) was AZ 348-54-23 0.08' and also fd. 3/8" x 1.1' re-rod (removed) was AZ 234-13-59 0.56' from L-1 set position.  
Peer group approved July 14, 1998.

C. Description of monument for corner and accessories established to perpetuate locating the position of the corner:

- L-1  
Set standard Allegan Co. Remon. monument (3/4" x 24" steel rod w/red cap #23520)  
Nail & remon. tag in N side power pole AZ 252°-56' 226.01'  
Nail & remon. tag in SW side power pole AZ 130°-51' 110.70'  
SW corner conc. block house fndn. AZ 48°-56' 115.20'  
Nail & remon. tag in NW side 15" maple AZ 50°-43' 87.45'  
L-13, T.4N., R.14W. AZ 89°-50'-51" 20.75'  
M-1, T.3N., R.14W. AZ 89°-50'-51" 2658.32'  
K-13, T.4N., R.14W. AZ 269°-50'-51" 2616.88'

Signed by [Signature]  
Surveyor's Michigan License No. 23520

Date 12-23-98

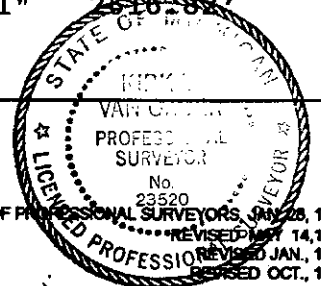

SURVEY  
REMONUMENTATION

APR 29 1995

SECTION

LIBERO 006 PAGE 48

Section A (continued from Page 1)

L-1

Heath Twp., T.3N., R.14W.

- (3) Kirk L. Van Order survey dated Feb. 2, 1995  
Set R.R. spike midway between K-1 and M-1 but on line with K-13 and  
M-1. 2658.46' West to K-1 and 2658.46' West to M-1.
- |                              |    |         |
|------------------------------|----|---------|
| Set nail in NW side 46" tree | NE | 30.30'  |
| Fd. PK SW side 28" ash       | NW | 46.51'  |
| R.R. spike (Overisel cor.)   | E  | 20.75'  |
| Fd. PK in power pole         | SE | 110.97' |
| Fd. 3/8" steel rod           | SW | 0.59'   |