
APR 0 7 1998

SECTION For corners in	LAND	LEGAN COUNTY REMON CORNER RECORDATI g Requirement of Act 74	ON CERTIFICAT		THE OF	98.	
Allegan	Located In:	Corner Code #	راه بد		.E	JAN	$\frac{\pi}{}$
(County)			other			21	
. Public Land Survey	TR_ TR_ TR_ TR_	EF-1 Heath Twp. EF-13 Overisel ((#9) Seq. #11)			PH 1: 2	FILED
2. Property Confrolling in Section 3. Miscellaneous Property in Sec.	\$\frac{4}{5} \frac{3N}{N} \text{R}\$ \$\frac{33}{5} \text{T_4N} \text{R}\$ \$\frac{7}{5} \text{T_R}\$	14W Heath Twp.	-	Pagista	r of Deeds St	t.	la Normbor
			<u> </u>	Negisie	i di Deeds St	anih e Li	ie Number
Lot No, Recor				A B C	D E F C	ні	JKLM
, : iivate Olaniis				2 - 5 -	-5		-2
<i>""</i> 1 * * * 0 1				3			+
equirements of P.A. 74, Michiga	in P.A. of 1970, the come		d 2 above were in	5	89	-10-	-1112
onformance with regulations and Inited States Department of the I	nterior, Bureau of Land M	lanagement or by a decree of a Co	ourt of Law and /or	6 -18	_1716	_15	-1413
nat the corner points mentioned loard of Land Surveyors or by	a Decree of a Court of			7	- - -		
ecovered, found as expressed be				8 -19	-2021	-22	-2324
IOTE: Not more than 2 corn on this certificate.	ers, all in the same town	n and range, may be recorded	,	10-30-	2928	27	2525
				11			
				12 31	-32 -33	_34	-3536
. Description of original mo	nument and accessori	es and/or subsequent restor	ation:	13	<u>: </u>		<u></u>
			DAT	P.A	ONUMENTATI A. 345 OF 1990 EGAN COUNT! ID 11-1/	-97	ER
Set standard Section 4, T higher lowlan AZ 91°14′02" AZ 271°14′02" AZ 91°14′02" This position monument is a corner. Peer group ap Description of monument Set standard i cap #23520) Nail & Remon. Nail & Remon.	Allegan Cours 3N., R.14W. d on West si 1042.82 fe 1597.69 f 1118.72 fe 1515.75 fe n not estable ccepted as t proved Nov. for corner and access Allegan Count tag in SE s tag in NE s tag in SE s tag in SE s	ories established to perpetua ty witness monum ide 5" Ash ide 8" Ash ide 5" Ash ide 16" Red Oak	went on No., T.4N., It ver being d position ed position d position d position nal governal evidence telocating the position of the locating the	E-1, 1 F-1, E-13, F-13, F-13. ment s of the	respect and surveyor positi	ively s. on of	y on This the
ast -	11/2/	/	•				
Signed by	11- (July		Date	12-31	1-97		
Surveyor's Michigan License	No. 23520						
	0000 404	Page 1 of	2 APPROVED BY MICHIGA	N STATE BOAR!	D OF PROFESSION	AL SURVEYO	ORS, JAN. 28. 197

USER 0006 PAGE 120

FORM APPROYED BY MICHIGAN STATE BOARD OF PROFESSIONAL SURVEYORS, JAN. 25, 167
REVISED JAN., 196
REVISED JAN., 196
REVISED JAN., 196

~~ ·

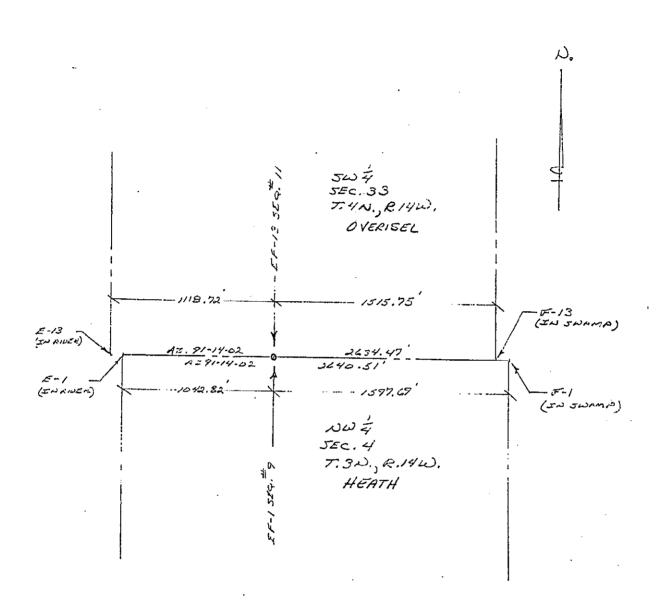

Page 2 of 2