

**LAND CORNER RECORDATION CERTIFICATE**  
**Filing Requirement of Act 74, Mich. P.A. 1970**

For corners in  
Allegan  
 (County)

Located In: \_\_\_\_\_ Corner Code # \_\_\_\_\_

1. Public Land Survey	T	3N	R	14W	M2
	T	3N	R	14W	M3
	T	3N	R	14W	M4
	T		R		
2. Property Controlling in Section	S		T	R	
	S		T	R	
3. Miscellaneous Property in Sec.	S		T	R	
	S		T	R	

Register of Deeds Stamp & File Number

4. Lot No. \_\_\_\_\_, Recorded Plat \_\_\_\_\_  
 5. Private Claims \_\_\_\_\_

M4 April 19, 1993  
 M3 July 11, 1992  
 M2 April 15, 1993

I, Gary C. Bilow, in a field survey on \_\_\_\_\_, 19\_\_\_\_, do hereby certify that under requirements of P.A. 74, Michigan P.A. of 1970, the corner points mentioned in lines 1 and 2 above were in conformance with regulations and rules therefore as required in the current manual of survey instructions of the United States Department of the Interior, Bureau of Land Management or by a decree of a Court of Law and/or that the corner points mentioned in lines 3, 4 and 5 above were in conformance with the rules of the Michigan Board of Land Surveyors or by a Decree of a Court of Law; established, re-established, monumented, re-monumented, recovered, found as expressed below:

**NOTE: Not more than 4 corners, all in the same town and range, may be recorded on this certificate.**

	A	B	C	D	E	F	G	H	I	J	K	L	M
2		6		5		4		3		2		1	●
3													●
4		7		8		9		10		11		12	●
5													
6		18		17		16		15		14		13	
7													
8		19		20		21		22		23		24	
9													
10		30		29		28		27		26		25	
11													
12		31		32		33		34		35		36	
13													

**A. Description of original monument and accessories and/or subsequent restoration:**

M2: Post established by U.S. Deputy Surveyor C. Britain in 1831 - accessories: Pine 20 S54W 73 links and Pine 24 N25W 32 links. Survey obtained from E. Van Order (PS #23520) shows a distance tie to this corner from corner M3 but does not describe it or give any accessories.  
 M3: Post established by U.S. Deputy Surveyor L. Lyon in 1830 - accessories: W. Oak 17 N62W 61 links and W. Oak 17 S79W 40 links. Survey records obtained from E. Van Order (PS #23520) dated 3-22-88 state "Found 1-1/2" pipe - accessories: 15" Black Oak WSW 23.95', 31" White Oak NNE 57.22', 14" Cherry NW 53.40', 1/2" rerod N 55.12".  
 M4: Post established by U.S. Deputy Surveyor L. Lyon in 1830 - accessories: Pine 32 S42W 417 links. No other records found.


**B. Description of corner evidence found and/or method applied in restoring or reestablishing corner:**

M2: Found 1-1/4" iron pipe at distance call per Van Order's survey from corner M3 and GLO distance from the West 1/4 corner (A2) Section 6 T3N R13W. Accepted pipe as the best evidence of the original GLO post.  
 M3: Did not find 1-1/2" pipe - reset corner from witness. Distance tie to corner M2 per Van Order's survey work sheet checked as well as GLO distance call to Corner A3 T3N R13W. Also GLO distance from corner M7 (recorded this date) to M3 (10560' vs 10569.81' measured) was reasonable and consistent. Accepted as the best evidence of the original GLO post.  
 M4: Reestablished corner midway on line between corners M3 and M5 (both recorded this date).

**C. Description of monument for corner and accessories established to perpetuate locating the position of the corner:**

M2: Found 1-1/4" iron pipe and raised with 1/2" x 24" rebar with plastic cap stamped "G.C. Bilow LLS 26453" S64W 66.9', Nail & Tag in Power pole S24E 26.6', Nail & Tag in Stop sign post N41E 53.1', Nail & Tag in "John Deere Street" sign post North 34.89', Found Capped rebar (West 1/4, Section 6, T3N, R13W)	M3: Set 1/2" x 24" rebar with plastic cap stamped "G.C. Bilow LLS 26453" WSW 23.95', Nail in 15" Black Oak NNE 57.22', Nail in 31" White Oak NW 53.40', Nail in 14" Cherry North 55.12', 1/2" rerod	M4: Set 1/2" x 24" rebar with plastic cap stamped "G.C. Bilow LLS 26453" N84E 11.76', Nail & Tag in 14" Oak S52E 37.12', Nail & Tag in 11" Oak S25E 55.45', Nail & Tag in 11" Pine N2E 17.45', Capped rebar (PS 26453)
---	---	--

Signed by Gary C. Bilow Date 5/16/93  
 Surveyor's Michigan License No. 26453

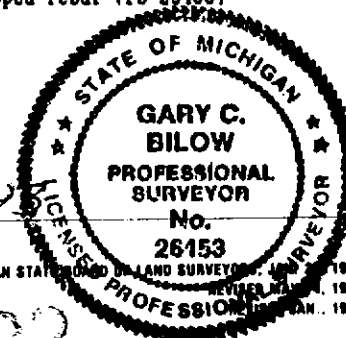

FORM APPROVED BY MICHIGAN STATE BOARD OF LAND SURVEYORS, 1971  
 REVISED JAN. 1975  
 LICENSED PROFESSIONAL SURVEYOR