


FROM ALLEGAN DAM #1


68

532.1

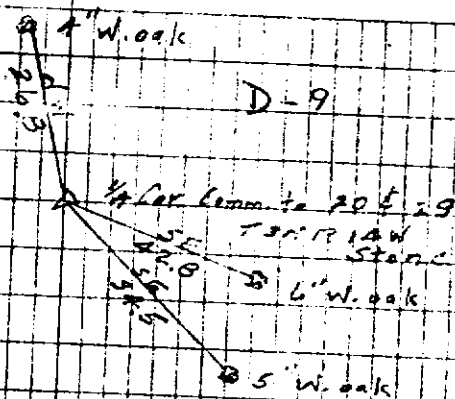

D-9

485

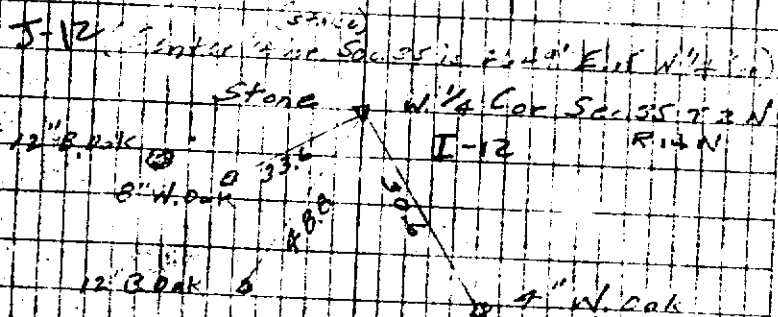

486