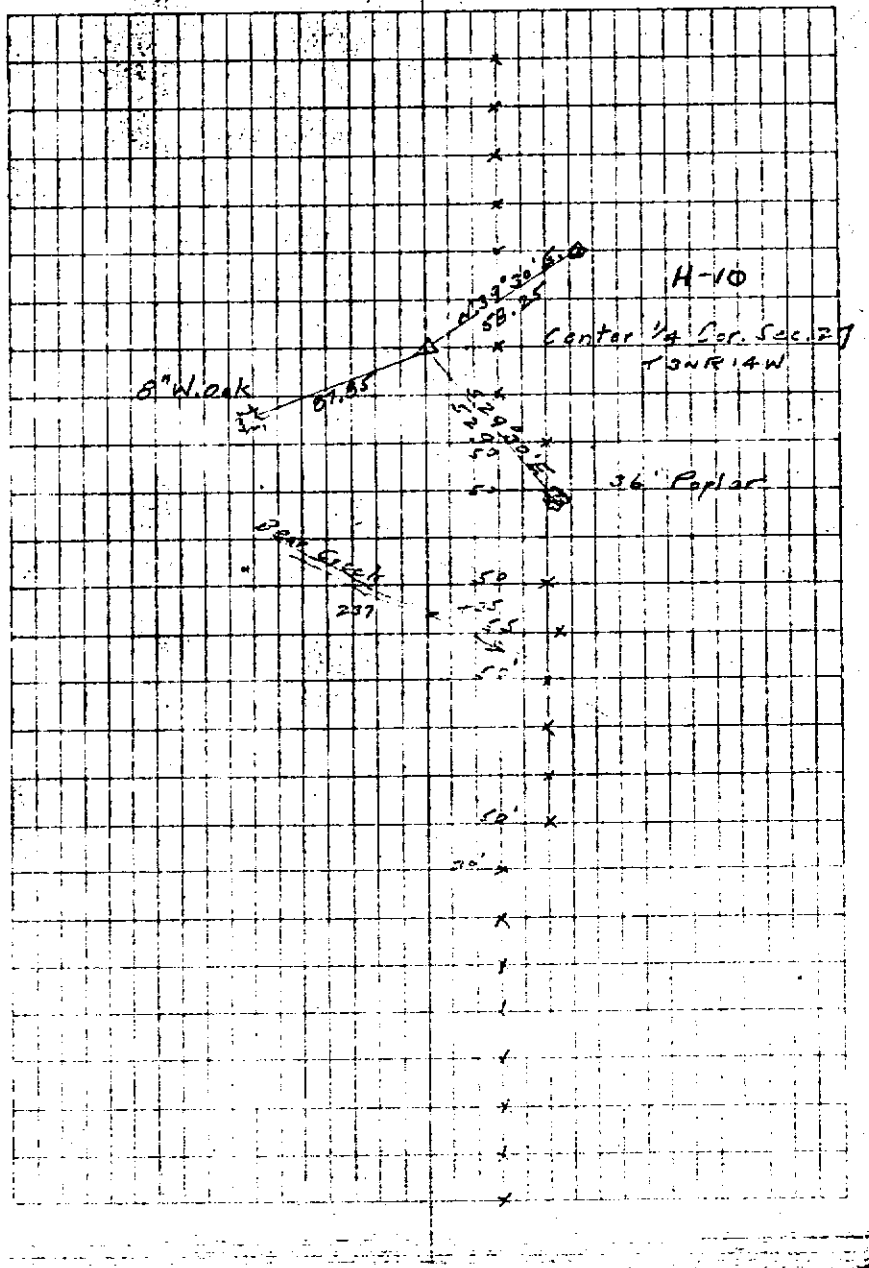FROM ALLEGAN DAM #1