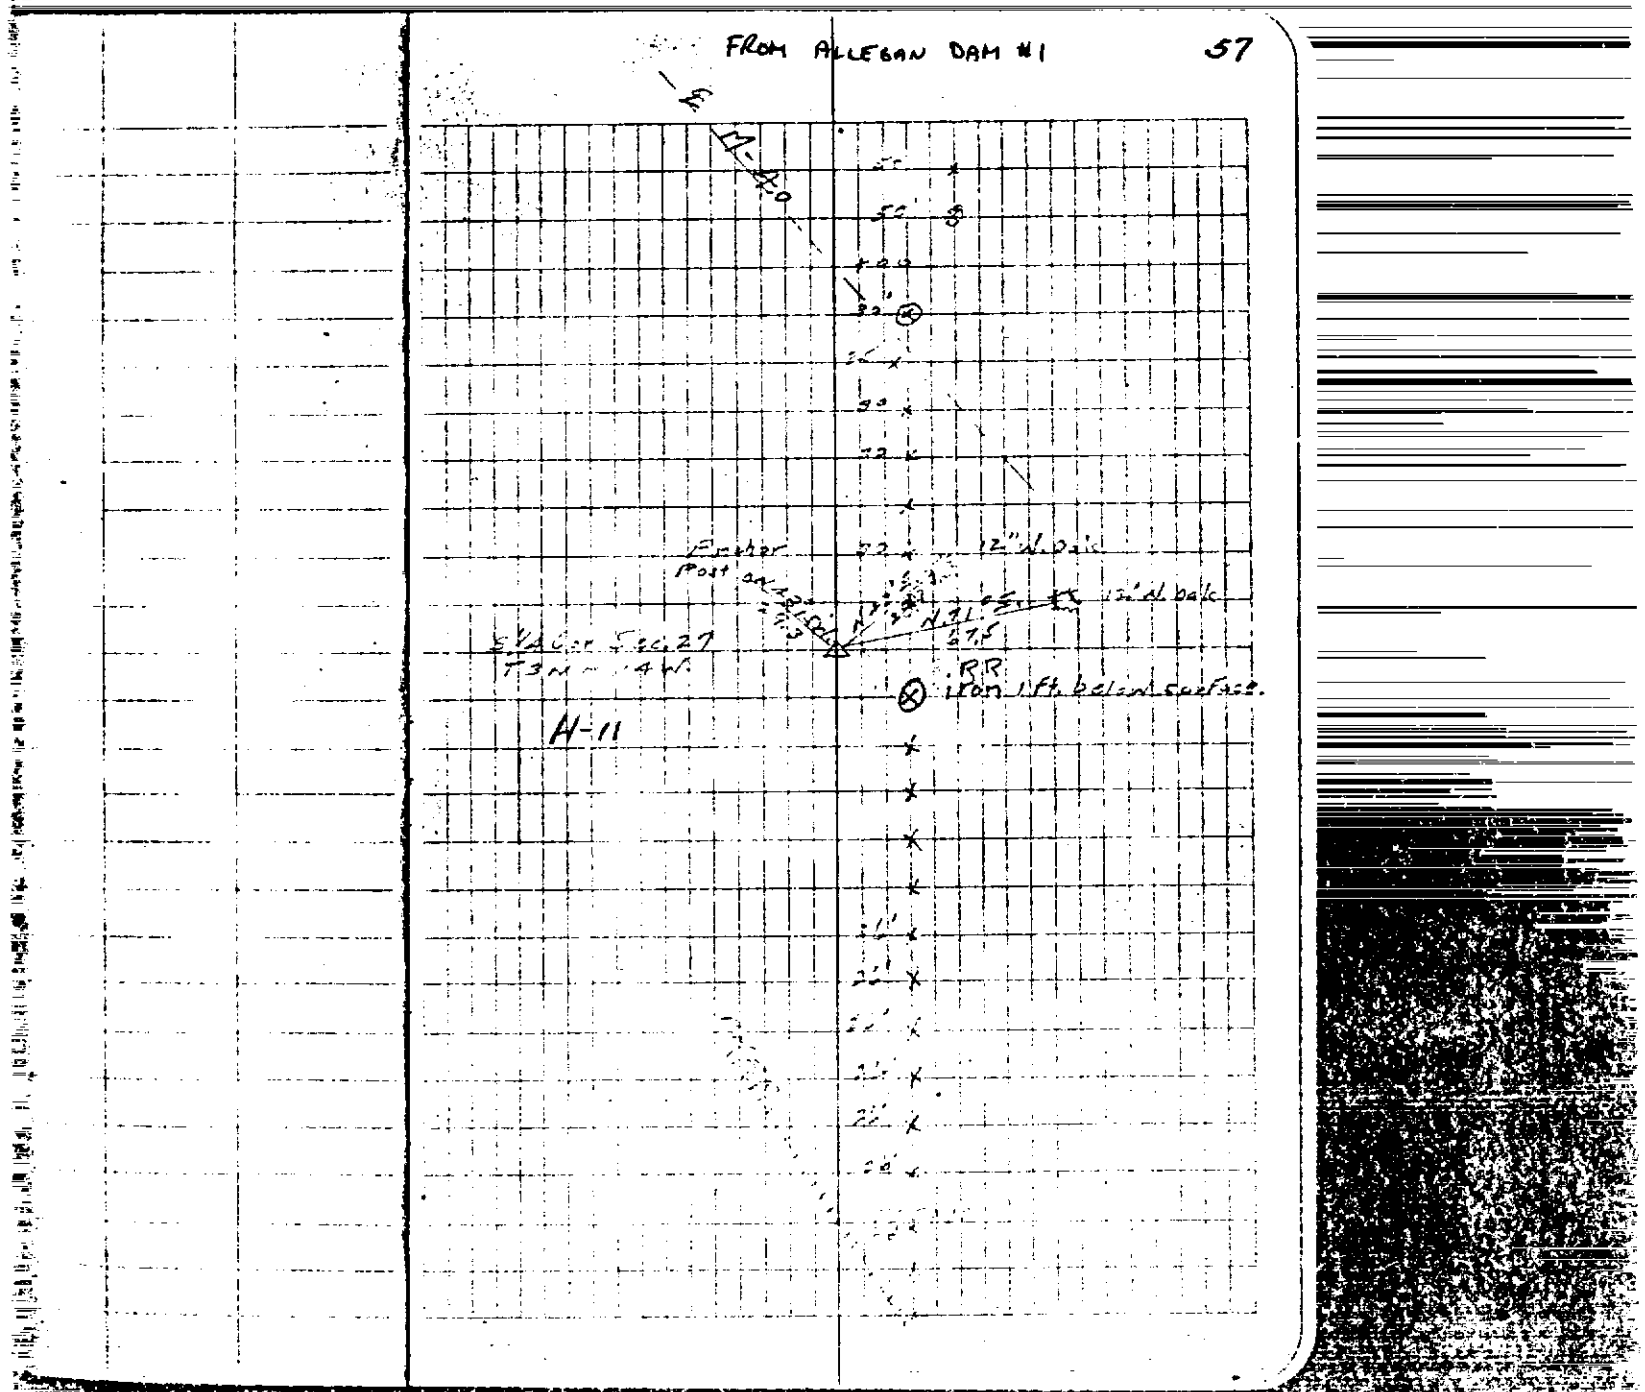FROM ALLEGAN DAM #1 57