


FROM ALLEGANY DAM # 11

5

Sta. 63+16.9

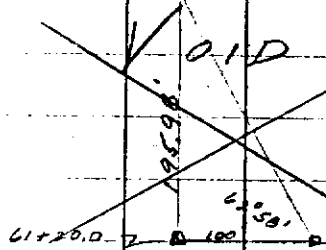

Triangulation
across RIVER

61+26.0

2011

PL 3,
1x3x24" stake

12"
B. oak

Thin 6" Oaks

15' 297 59.6

162° W

29.7

10" B. oak

C-11

500 Cor. points Secs. 29, 30,
31 & 32 T5N R14W, 12 1.5' W
of Sta. 5 St. 2 A B Stake
at surface with 1005 tower
to Sec. Corner

59.9° E

20.4

9" W. oak

5.57° E

40.6

9" W. oak

5.57° E

40.6

10" Twin W. oak