


"OTHER" CORNER MAP

HEATH

T.3N.-R.14W.

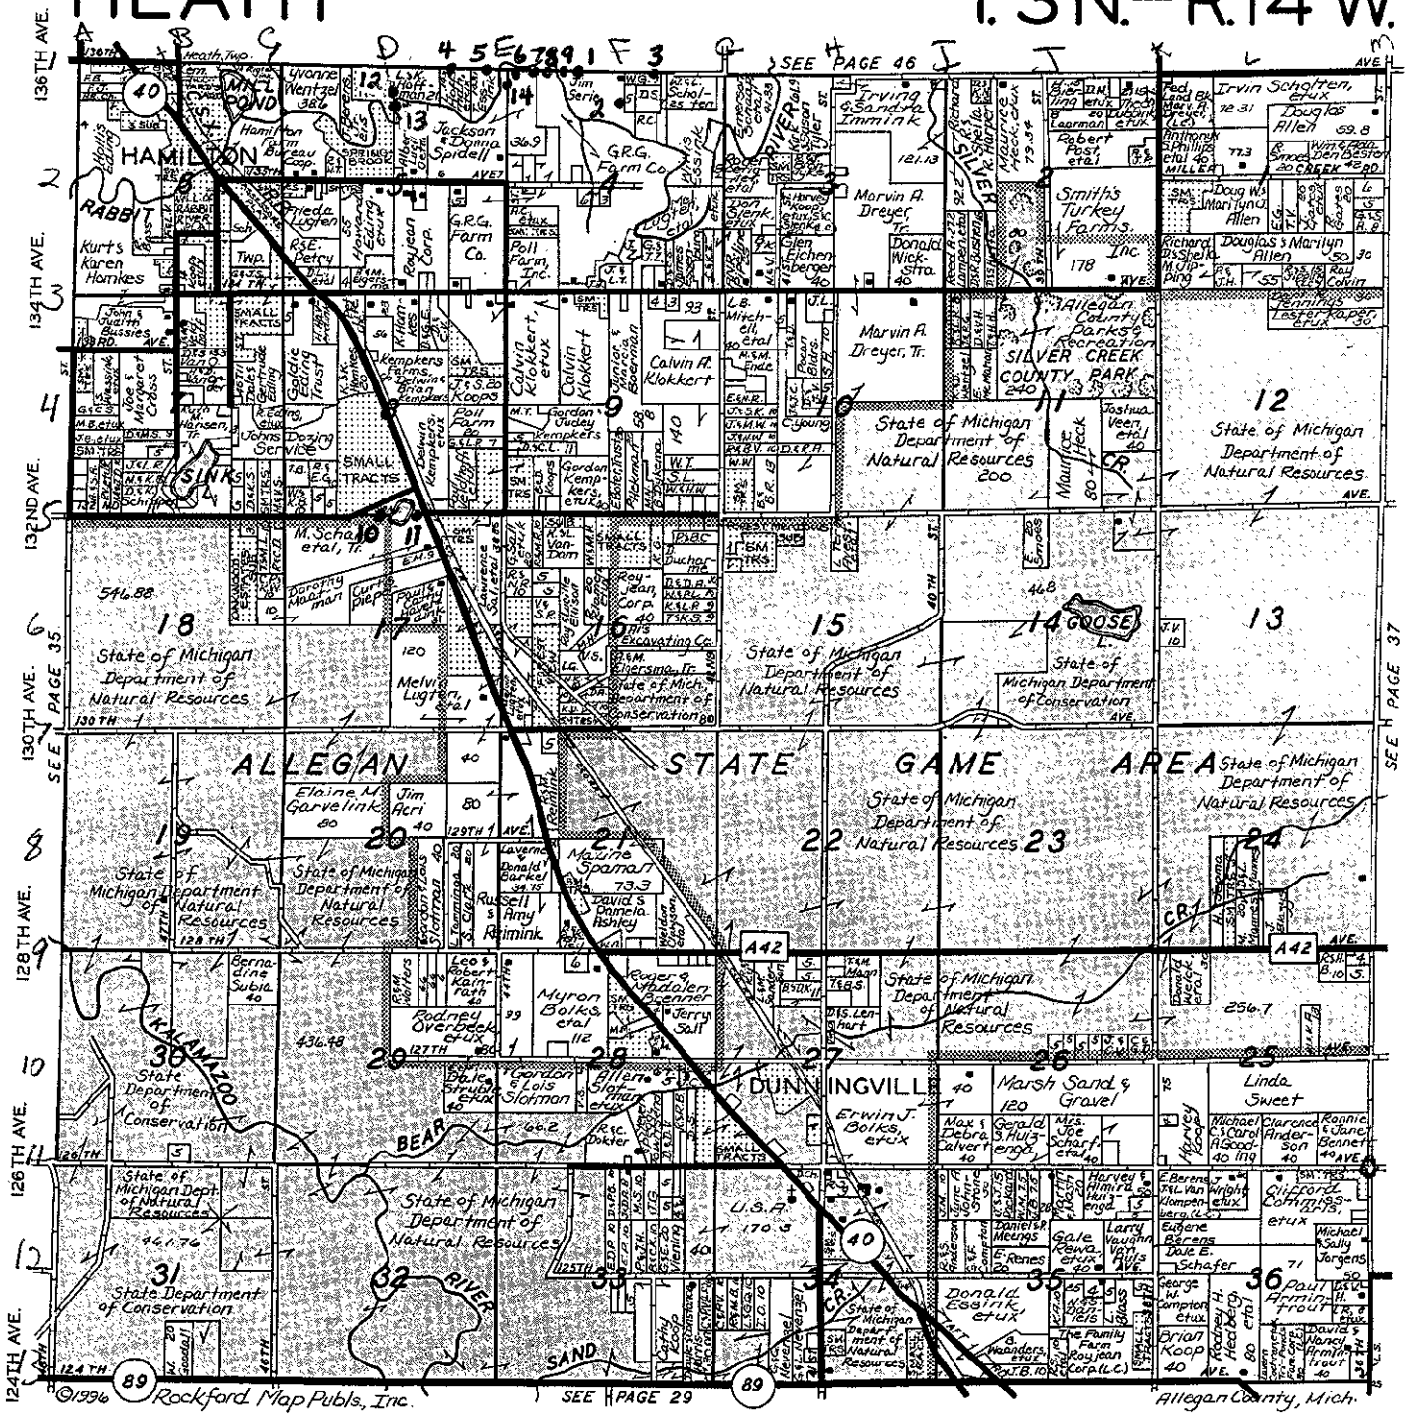

48TH ST. 46TH ST. 44TH ST. 42ND ST. 40TH ST. 38TH ST. 36TH ST.

1996 = #1, #2, #3 1997 = #4, #5, #6, #7, #8, #9 1998 = #10, #11, #12, #13, #14



HFB HAMILTON FARM BUREAU

Feed Agronomy Petroleum Chevrolet Hardware Lumber Eggs


Hamilton Farm Bureau, Hamilton (616) 751-5171 or (800) 442-4137