

28

TERRILL, KISTLER & ANDERSON, INC.

ALLEGAN COUNTY  
SEC. 14 T 3 N, R 15 W MANLIUS TWP.

I-5  
1. FOUND BOLT AND PIECES OF STONE (DRG '71)  
31.87' NE. TO 36" OAK  
72.42' NE. TO 12" BICKORY  
458 97.98' NE. TO 16" WALNUT  
204.27' NW. TO POWER POLE  
65.44' SW. TO POWER POLE


J-5  
5. FOUND 2" IRON PIPE (DRG '71)  
SET CONC. MON.  
249 69.18' SOUTH TO 14" WHITE OAK  
34.14' NNW. TO 12" BLACK OAK  
35.74' SW. TO 10" BLACK OAK  
459 11.34' SE. TO 12" WHITE OAK  
4.50' WEST TO 8" WHITE OAK WITH WIRE

K-5  
2. FOUND GRADER BLADE (DRG '71)  
250 80.00' SE. TO 24" WHITE OAK  
91.22' SW. TO 12" WHITE OAK  
140.87' NE. TO TRIPLE 11" WHITE PINE  
460 57.24' NE. TO 6" CHERRY

I-6  
6. FOUND ROUND STEEL ROD (DRG '71)  
36.65' N6. TO 12" WHITE OAK  
251 62.65' S60°E TO 10" BLACK OAK  
77.78' S80°E TO 18" BLACK OAK  
75.21' NW. TO POWER POLE  
461 33.65' S20°E TO 12" OAK  
24.30' NE. TO 14" OAK

I-7  
4. FOUND CONC. MON. (DRG '71)  
283 69.36' N10°W TO 8" BLACK OAK  
252 93.15' N20°E TO 12" BLACK OAK  
463 21.62' S65°E TO 18" WHITE OAK  
5.42' SOUTH TO 18" BLACK OAK

J-7  
7. FOUND IRON PIPE (DRG '71) ON OLD FENCE LINE TO NORTH.  
464 60.35' S16°W TO 8" BLACK OAK  
56.42' N12°E TO 16" BLACK OAK  
253 32.35' N99°E TO 14" WHITE OAK  
288 53.26' N24°W TO 6" WHITE OAK  
37.51' S60°W TO 10" BLACK OAK

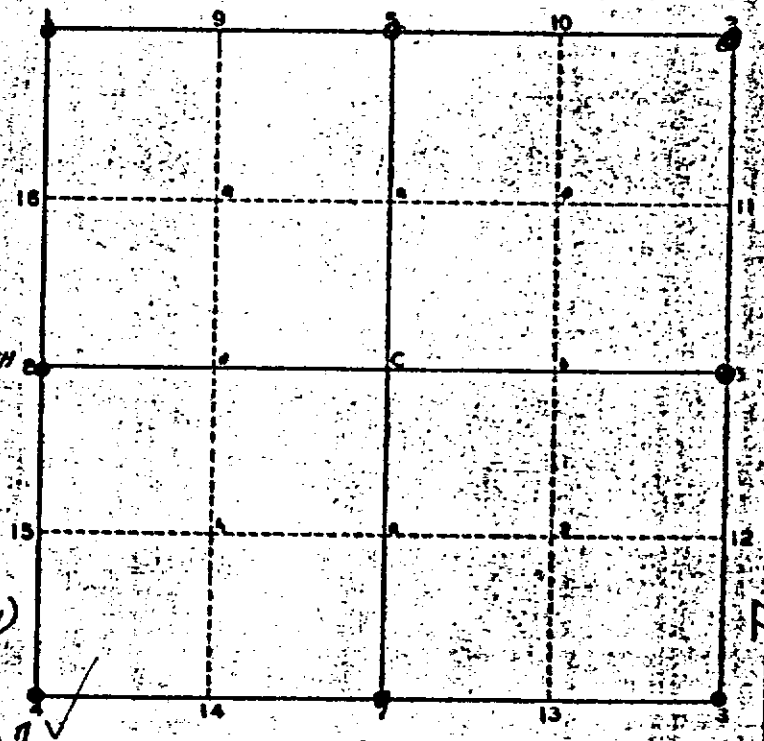

K-1  
3. SET CONC. MON. ON OLD FENCE LINE TO SOUTH.  
56.88' SOUTH TO 12" BLACK OAK  
45.19' SE. TO 18" BLACK OAK  
21.11' NE. TO 16" BLACK OAK (MOST SOUTHERLY OF A GROUP OF THREE)  
94.93' N10°E TO 12" WHITE OAK

K-6  
6. SET CONC. MON. MIDWAY AND ON LINE BETWEEN SECTION CORNERS (DRG '71)  
78.62' NE. TO 10" BLACK OAK  
26.70' NE. TO 6" BLACK OAK  
60.43' EAST TO 8" WHITE OAK  
13.12' WEST TO 6" BLACK OAK (MOST NORTHERLY OF THREE)  
33.74' NW. TO 6" WHITE OAK  
6.0 EAST TO @ OF TRAIL

FRANKLIN PRESS

JOHN KISTLER & ASSOCIATES, INC.  
Civil Engineers, Land Surveyors &  
Community Planning  
302 S. Beachtree  
Grand Haven, Michigan 49417

R BASE