D. A. RATEKIN
#8781

3N 15W

SECTION 35 MANLIUS TOWNSHIP

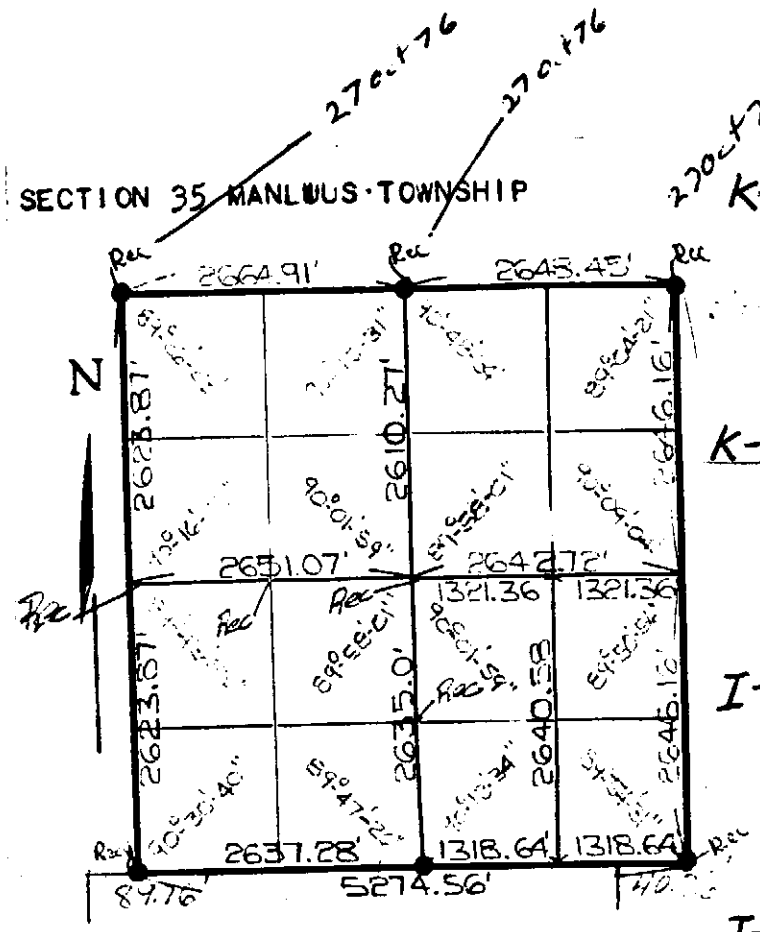

K-13 [illegible]

257

K-11 NE CORNER 1/2" IRON
18" CEDAR S65°E 158.3'
℄ E & W ROAD NORTH 27.5'
2" ANGLE IRON S45°W 0.25'
12" BLACK OAK S25°W 43.6'
8" TWIN OAK N85°W 24.9'
12" OAK N60°E 118.7'

258
298

I-13 SW CORNER 1 1/2" IRON [illegible] BOX
EAST HEADWALL N40°E 30.10'
WEST HEADWALL N35°W 32.75'
INTERSECTION M-89 & 52ND ST. SOUTH 22.10'
POWER POLE N 15°W 56.45'
M-89 ROUTE MARKER SIGN N75°W 50.70'
STREET SIGN SOUTH 45.40'

259

I-11 NW CORNER 5/8" IRON
12" OAK N42W 70.2'
TRIPLE OAK 2@12" & 1@6" S13°W 143.9'
USGS MARKER PT STA NO. 79
1925' S32W 28.76'
18" OAK N20°E 33.05'
70°

333
267
281
256

J-11 N 1/4 POST 1 1/4" ANGLE IRON
16" OAK S10°E 79.65'
20" OAK S35°W 93.5'
WEST GATE POST N15°W 31.4'
EAST GATE POST N15°E 34.2'
℄ OF E & W RD. 10' NORTH
IN LINE WITH DRIVE TO NORTH
65' WEST OF EAST LINE FENCE TO NORTH

274
331
260
261

PAGE 23