

LAND CORNER RECORDATION CERTIFICATE
Filing Requirement of Act 74, Mich. P.A. 1970

For corners in
ALLEGAN

(County)	Located In:	Corner Code <i>##</i>
1. Public Land Survey	T _____ R _____	_____
	T _____ R _____	_____
	T _____ R _____	_____
	T _____ R _____	_____
2. Property Controlling in Section	S <u>36</u> T <u>3N</u> R <u>15W</u>	<u>5</u>
	S <u>36</u> T <u>3N</u> R <u>15W</u>	<u>6</u>
3. Miscellaneous Property in Sec.	S <u>36</u> T <u>3N</u> R <u>15W</u>	<u>4</u>
	S _____ T _____ R _____	_____

Register of Deeds Stamp & File Number

4. Lot No. _____, Recorded Plat _____
 5. Private Claims _____

	A	B	C	D	E	F	G	H	I	J	K	L	M
2	6		5		4		3		2		1		
3													
4	7		8		9		10		11		12		
5													
6	18		17		16		15		14		13		
7													
8	19		20		21		22		23		24		
9													
10	30		29		28		27		26		25		
11													
12	31		32		33		34		35		36		
13													

I, GARY C. BILOW, in a field survey on APRIL 15, 19 91, do hereby certify that under requirements of P.A. 74, Michigan P.A. of 1970, the corner points mentioned in lines 1 and 2 above were in conformance with regulations and rules therefore as required in the current manual of survey instructions of the United States Department of the Interior, Bureau of Land Management or by a decree of a Court of Law and/or that the corner points mentioned in lines 3, 4 and 5 above were in conformance with the rules of the Michigan Board of Land Surveyors or by a Decree of a Court of Law; established, re-established, monumented, re-monumented, recovered, found as expressed below:


NOTE: Not more than 4 corners, all in the same town and range, may be recorded on this certificate.

- A. Description of original monument and accessories and/or subsequent restoration:
- (5) CORNER NOT SET IN ORIGINAL SURVEY. FOUND NO SUBSEQUENT RECORD OF ESTABLISHMENT.
 - (6) CORNER NOT SET IN ORIGINAL SURVEY. FOUND NO SUBSEQUENT RECORD OF ESTABLISHMENT.
 - (4) CORNER NOT SET IN ORIGINAL SURVEY. FOUND NO SUBSEQUENT RECORD OF ESTABLISHMENT.

- B. Description of corner evidence found and/or method applied in restoring or reestablishing corner:
- (5) ESTABLISHED CORNER POSITION MIDWAY AND ON A STRAIGHT LINE BETWEEN L-11 AND L-12 AS RECORDED THIS DATE. MONUMENTED THE POSITION WITH A 1/2"x36" REBAR ENCASED IN A 4" DIAMETER CONCRETE CYLINDER CAPPED WITH A CAST ALUMINUM MICHIGAN DEPARTMENT OF NATURAL RESOURCES TABLET. FROM THE POSITION MONUMENTED, I FOUND A 1 1/4" IRON PIPE 0.43' EAST AND 0.57' NORTH.
 - (6) ESTABLISHED CORNER POSITION AT THE INTERSECTION OF STRAIGHT LINES CONNECTING (2) WITH (9) AND (5) WITH (7). CORNERS 2, 5, AND 9 ARE MONUMENTED POSITIONS AND ARE AS RECORDED THIS DATE. CORNER 7 IS A COMPUTED POSITION MIDWAY AND ON A STRAIGHT LINE BETWEEN M-11 AND M-12 BOTH AS RECORDED THIS DATE. MONUMENTED THE CORNER POSITION WITH A 1/2"x36" REBAR ENCASED IN A 4" DIAMETER CONCRETE CYLINDER CAPPED WITH A CAST ALUMINUM MICHIGAN DEPARTMENT OF NATURAL RESOURCES TABLET, PROJECTING 4" ABOVE GROUND. FROM THE CORNER POSITION MONUMENTED, I FOUND A 1" DIAMETER IRON PIPE 1.6' NORTH AND 1.0' WEST. THE INTERSECTION OF THE FALLEN WIRE STRANDS OF AN OLD FENCE LINE RUNNING NORTH, SOUTH AND EAST, BEARS N39°W, 4.6' DISTANT.
 - (4) FOUND NO EVIDENCE OF PREVIOUS MONUMENTATION. ESTABLISHED CORNER AT THE INTERSECTION OF STRAIGHT LINES CONNECTING CORNERS 1 WITH 8 AND 3 WITH 5. CORNERS 1, 5, AND 8 ARE MONUMENTED POSITIONS AND ARE AS RECORDED THIS DATE. CORNER 3 IS A COMPUTED POSITION MIDWAY AND ON A STRAIGHT LINE BETWEEN K-11 AND K-12 BOTH AS RECORDED THIS DATE. I MONUMENTED THE CORNER POSITION WITH A 4" DIAMETER CONCRETE MONUMENT AS DESCRIBED ABOVE.

- C. Description of monument for corner and accessories established to perpetuate locating the position of the corner:
- | | | |
|---|--|---|
| (5) SET CONCRETE MONUMENT WITH MDNR CAP | (6) SET CONCRETE MONUMENT WITH MDNR CAP | (4) SET CONCRETE MONUMENT WITH MDNR CAP |
| N37W 39.93' EAST FACE 14" OAK | N15E 19.69' WEST FACE 11" TWIN RED PINE AT BASE | N25W 51.82' SW FACE 8" WHITE PINE |
| N20E 18.14' WEST FACE 8" OAK | S22E 9.54' NE FACE 10" OAK | N10E 29.84' WEST FACE 7" CHERRY |
| S05E 27.80' EAST FACE OF W'LY BOLE OF TWIN 14" BLACK CHERRY | N75W 27.41' SOUTH FACE 9" OAK | S36W 37.62' SE FACE S'LY BOLE OF 7" TWIN OAK |
| WEST 1.80' SOUTH FACE OF A WOOD POST (ALL MEASUREMENTS ABOVE ARE TO NAILS WITH MDNR TAGS) | N35W 31.92' SW FACE 8" WHITE PINE (ALL MEASUREMENTS ABOVE ARE TO NAILS WITH MDNR TAGS) | N80W 14.91' SOUTH FACE 8" TRIPLE OAK AT BASE (ALL MEASUREMENTS ABOVE ARE TO NAILS WITH MDNR TAGS) BLAZED TREES AT BASE AND BH |

Signed by Gary C. Bielow Date 8/15/91
 Surveyor's Michigan License No. 26453

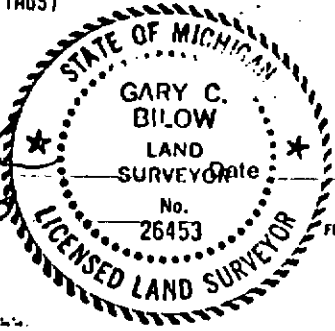

FORM APPROVED BY MICHIGAN STATE BOARD OF LAND SURVEYORS, JAN. 28, 1971
 REVISED MAY 14, 1975
 REVISED JAN., 1983