

LAND CORNER RECORDATION CERTIFICATE
Filing Requirement of Act 74, Mich. P.A. 1970

For corners in
ALLEGAN
(County)

Located In: _____ Corner Code ##

- | | | |
|------------------------------------|--------------------------------------|-------------|
| 1. Public Land Survey | T <u>3N</u> R <u>15W</u> | <u>M-11</u> |
| | T <u>3N</u> R <u>15W</u> | <u>M-12</u> |
| | T _____ R _____ | _____ |
| | T _____ R _____ | _____ |
| 2. Property Controlling in Section | S <u>36</u> T <u>3N</u> R <u>15W</u> | <u>9</u> |
| | S _____ T _____ R _____ | _____ |
| 3. Miscellaneous Property in Sec. | S _____ T _____ R _____ | _____ |
| | S _____ T _____ R _____ | _____ |

Register of Deeds Stamp & File Number

4. Lot No. _____, Recorded Plat _____
 5. Private Claims _____

	A	B	C	D	E	F	G	H	I	J	K	L	M
2	6	5	4	3	2	1							
3	7	8	9	10	11	12							
4													
5													
6	18	17	16	15	14	13							
7													
8	19	20	21	22	23	24							
9													
10	30	29	28	27	26	25							
11													
12	31	32	33	34	35	36							
13													

I, GARY C. BILOW, in a field survey on APRIL 15, 1991, do hereby certify that under requirements of P.A. 74, Michigan P.A. of 1970, the corner points mentioned in lines 1 and 2 above were in conformance with regulations and rules therefore as required in the current manual of survey instructions of the United States Department of the Interior, Bureau of Land Management or by a decree of a Court of Law and/or that the corner points mentioned in lines 3, 4 and 5 above were in conformance with the rules of the Michigan Board of Land Surveyors or by a Decree of a Court of Law; established, re-established, monumented, re-monumented, recovered, found as expressed below:

NOTE: Not more than 4 corners, all in the same town and range, may be recorded on this certificate.

A. Description of original monument and accessories and/or subsequent restoration:

(M-11) ORIGINAL CORNER POST ESTABLISHED BY U.S. GOVERNMENT DEPUTY SURVEYOR L. LYON, 1832. ACCESSORIES: B. OAK 8 N20W 90, B. OAK 8 S34W 4.71. FALLING OF NORTHWEST CORNER SEC 31, T3N-R14W IS 0.70 SOUTH OF M-11 PER NOTES OF C. BRITAIN, 1832 FOR SUBDIVISIONS OF T3N-R14W. FOUND NO OTHER RECORD OF PERPETUATION OR REESTABLISHMENT.

(M-12) ORIGINAL POST ESTABLISHED BY U.S. GOVERNMENT DEPUTY SURVEYOR L. LYON, 1832. ACCESSORIES: PINE 6 N30W 18, W. OAK 7 S26W 23. FIELD SURVEY NOTES ca. 1937 BY UNKNOWN SURVEYOR (FROM BOOK 3, PAGE 91). SHOWN CORNER AS IRON PIPE WITH THE FOLLOWING ACCESSORIES: N62E 75.6' 8" B. OAK, S55E 29.47' 8" PINE, S18E 90.45' 10" W. OAK.

(9) CORNER NOT SET IN ORIGINAL SURVEY. FOUND NO RECORD OF SUBSEQUENT ESTABLISHMENT.

B. Description of corner evidence found and/or method applied in restoring or reestablishing corner:

(M-11) ORIGINAL POST AND ACCESSORIES NOT RECOVERED. RECOVERED 1/2" DIAMETER THREADED ROD ON SOUTHERLY PROJECTION OF OLD FENCE REMAINS AT THE NORTHWEST CORNER OF SECTION 31, T3N-R14W (A-11) AND ACCEPTED SAME AS THE BEST AVAILABLE EVIDENCE OF THE POSITION OF THE ORIGINAL CLOSING CORNER AND THE LOCATION OF THE RANGE LINE. ESTABLISHED M-11 AT U.S. DISTANCE (46.20') NORTH OF THREADED ROD AND ON A STRAIGHT LINE PASSING THROUGH THE ROD AND M-12, BOTH AS RECORDED THIS DATE. MONUMENTED THE POSITION WITH A 1/2"x3/8" REBAR ENCASED IN A 4" DIAMETER CONCRETE CYLINDER CAPPED WITH A CAST ALUMINUM MICHIGAN DEPARTMENT OF NATURAL RESOURCES TABLET.

(M-12) ORIGINAL POST AND ACCESSORIES NOT RECOVERED. FOUND A 1" DIAMETER IRON PIPE 6" BELOW AND 3' WEST OF THE CENTERLINE OF THE GRAVEL SURFACE OF 48TH STREET. 1937 ACCESSORIES TO 8" (NOW 15") PINE AND 10" (NOW 19") W. OAK CHECK AND ARE IN GOOD SHAPE. ACCEPTED PIPE AS THE BEST AVAILABLE EVIDENCE OF THE POSITION OF THE ORIGINAL CORNER AND DROVE A 1/2"x24" REBAR WITH YELLOW PLASTIC CAP STAMPED "G.C. BILOW LLS 26453" INTO IT'S CENTER.

(9) FOUND NO MONUMENTATION AT THIS POSITION. ESTABLISHED CORNER MIDWAY AND ON A STRAIGHT LINE BETWEEN L-12 AND M-12 AS RECORDED THIS DATE. MONUMENTED THE POSITION WITH A 1/2"x3/8" REBAR ENCASED IN A 4" DIAMETER CONCRETE CYLINDER CAPPED WITH A CAST ALUMINUM MICHIGAN DEPARTMENT OF NATURAL RESOURCES TABLET.


C. Description of monument for corner and accessories established to perpetuate locating the position of the corner:

(M-11) SET CONCRETE MONUMENT WITH MDNR CAP N83W 42.63' SET NAIL AND MDNR TAG IN NORTH FACE 4" PINE
 N42W 48.62' SET NAIL AND MDNR TAG IN EAST FACE 5" WHITE OAK
 EAST 13.86' SET NAIL AND MDNR TAG IN NORTH FACE 13" WHITE OAK
 N30E 23.76' SET NAIL AND MDNR TAG IN EAST FACE 7" WHITE OAK
 SOUTH 16' CENTERLINE OF GRAVEL SURFACE OF 126TH AVENUE

(M-12) FOUND 1" PIPE AND ADDED 1/2" REBAR WITH CAP #26463 IN CENTER.
 S62W 34.29' SET NAIL AND MDNR TAG IN SOUTH FACE 7" WHITE PINE
 N73E 21.14' SET NAIL AND MDNR TAG IN NORTH FACE 6" WHITE PINE
 N27W 55.20' SET NAIL AND MDNR TAG IN SW FACE 14" RED PINE
 N82W 12.34' SET NAIL AND MDNR TAG IN SOUTH FACE 8" TWIN WHITE OAK.

(9) SET CONCRETE MONUMENT WITH MDNR CAP NOSE 61.85' SET NAIL AND MDNR TAG IN EAST FACE 9" TRIPLE RED PINE
 N20E 66.73' SET NAIL AND MDNR TAG IN WEST FACE 10" TWIN RED PINE
 N65E 25.00' SET NAIL AND MDNR TAG IN SE FACE 11" TWIN RED PINE
 S60E 54.20' SET NAIL AND MDNR TAG IN NORTH FACE 12" WHITE OAK

Signed by Gary C. Bilow Date _____
 Surveyor's Michigan License No. 26453

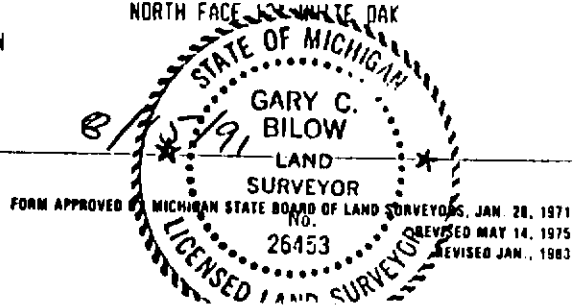

(BLAZED ALL ABOVE TREES AT BASE AND BH)