

LAND CORNER RECORDATION CERTIFICATE
Filing Requirement of Act 74, Mich. P.A. 1970

For corners in
ALLEGAN

| (County) | Located In: | Corner Code =# |
|---------------------------------------|--------------------------------------|----------------|
| 1. Public Land Survey | T _____ R _____ | _____ |
| | T _____ R _____ | _____ |
| | T _____ R _____ | _____ |
| | T _____ R _____ | _____ |
| 2. Property Controlling in Section | S <u>35</u> T <u>3N</u> R <u>15W</u> | <u>13</u> |
| | S <u>35</u> T <u>3N</u> R <u>15W</u> | <u>14</u> |
| 3. Miscellaneous Property in Sec. | S <u>36</u> T <u>3N</u> R <u>15W</u> | <u>8</u> |
| | S _____ T _____ R _____ | _____ |

Register of Deeds Stamp & File Number

4. Lot No. _____, Recorded Plat _____
 5. Private Claims _____

| | A | B | C | D | E | F | G | H | I | J | K | L | M |
|----|----|---|----|---|----|---|----|---|----|---|----|---|---|
| 2 | 6 | | 5 | | 4 | | 3 | | 2 | | 1 | | |
| 3 | | | | | | | | | | | | | |
| 4 | 7 | | 8 | | 9 | | 10 | | 11 | | 12 | | |
| 5 | | | | | | | | | | | | | |
| 6 | 18 | | 17 | | 16 | | 15 | | 14 | | 13 | | |
| 7 | | | | | | | | | | | | | |
| 8 | 19 | | 20 | | 21 | | 22 | | 23 | | 24 | | |
| 9 | | | | | | | | | | | | | |
| 10 | 30 | | 29 | | 28 | | 27 | | 26 | | 25 | | |
| 11 | | | | | | | | | | | | | |
| 12 | 31 | | 32 | | 33 | | 34 | | 35 | | 36 | | |
| 13 | | | | | | | | | | | | | |

I, GARY C. BILOW, in a field survey on APRIL 15, 19 91, do hereby certify that under requirements of P.A. 74, Michigan P.A. of 1970, the corner points mentioned in lines 1 and 2 above were in conformance with regulations and rules therefore as required in the current manual of survey instructions of the United States Department of the Interior, Bureau of Land Management or by a decree of a Court of Law and/or that the corner points mentioned in lines 3, 4 and 5 above were in conformance with the rules of the Michigan Board of Land Surveyors or by a Decree of a Court of Law, established, re-established, monumented, re-monumented, recovered, found as expressed below:

NOTE: Not more than 4 corners, all in the same town and range, may be recorded on this certificate.

- A. Description of original monument and accessories and/or subsequent restoration:
- (13) CORNER NOT SET IN ORIGINAL SURVEY. FOUND NO RECORD OF SUBSEQUENT ESTABLISHMENT.
 - (14) CORNER NOT SET IN ORIGINAL SURVEY. FOUND NO RECORD OF SUBSEQUENT ESTABLISHMENT.
 - (8) CORNER NOT SET IN ORIGINAL SURVEY. FOUND NO RECORD OF SUBSEQUENT ESTABLISHMENT.


B. Description of corner evidence found and/or method applied in restoring or reestablishing corner:

- (13) FOUND NO MONUMENTATION AT THIS POSITION. MONUMENTED CORNER WITH 1/2"x36" REBAR ENCASED IN A 4" DIAMETER CONCRETE CYLINDER CAPPED WITH A CAST ALUMINUM MICHIGAN DEPARTMENT OF NATURAL RESOURCES TABLET AT THE INTERSECTION OF STRAIGHT LINES CONNECTING MONUMENTED CORNERS 12 AND 14 WITH 9 AND 16, ALL AS RECORDED THIS DATE.
- (14) FOUND NO MONUMENTATION AT THIS POSITION. MONUMENTED CORNER WITH CONCRETE MONUMENT AS DESCRIBED ABOVE MIDWAY AND ON A STRAIGHT LINE BETWEEN K-12 AND K-13 AS RECORDED THIS DATE.
- (8) MONUMENTED CORNER WITH CONCRETE MONUMENT AS DESCRIBED ABOVE MIDWAY AND ON A STRAIGHT LINE BETWEEN K-12 AND L-12 AS RECORDED THIS DATE. FROM THE MONUMENT SET, I FOUND A 5/8" IRON BAR WITH CAP #23520 1.62' NORTH AND 0.26' EAST.

C. Description of monument for corner and accessories established to perpetuate locating the position of the corner:

- | | | |
|---|--|--|
| (13) SET CONCRETE MONUMENT WITH MDNR CAP N50E 11.93' SET NAIL AND MDNR TAG IN WEST FACE 8" W. OAK | (14) SET CONCRETE MONUMENT WITH MDNR CAP EAST 3.00' SET NAIL AND MDNR TAG IN NORTH FACE 6" WHITE OAK | (8) SET CONCRETE MONUMENT WITH MDNR CAP N08E 29.82' SET NAIL AND MDNR TAG IN WEST FACE 12" OAK |
| S07W 13.89' SET NAIL AND MDNR TAG IN EAST FACE 8" OAK | N25E 18.02' SET NAIL AND MDNR TAG IN WEST FACE 5" OAK | S64E 21.32' SET NAIL AND MDNR TAG IN SOUTH FACE 8" OAK |
| N70W 15.54' SET NAIL AND MDNR TAG IN EAST FACE, 5'LY BOLE OF TWIN 7" OAK | S25W 15.92' SET NAIL AND MDNR TAG IN EAST FACE 12" WHITE OAK | S46W 6.72' SET NAIL AND MDNR TAG IN SE FACE 10" WHITE OAK |
| N10W 17.83' SET NAIL AND MDNR TAG IN EAST FACE, 5'LY BOLE OF TWIN 5" OAK | N70W 20.38' SET NAIL AND MDNR TAG IN SOUTH FACE 12" OAK (BLAZED TREES AT BASE AND BH) | N74W 28.19' SET NAIL AND MDNR TAG IN NE FACE 8" WHITE OAK (BLAZED TREES AT BASE AND BH) |

Signed by Gary C. Bilow
 Surveyor's Michigan License No. 26453

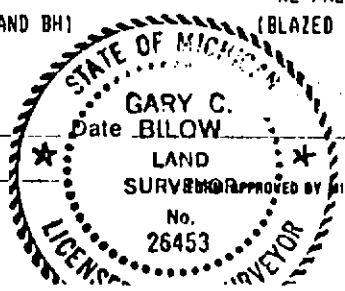

8/15/91

APPROVED BY MICHIGAN STATE BOARD OF LAND SURVEYORS, JAN. 28, 1971
 REVISED MAY 14, 1975
 REVISED JAN., 1983

PAGE 150

PAGE 150

PAGE 150