

LAND CORNER RECORDATION CERTIFICATE
Filing Requirement of Act 74, Mich. P.A. 1970

For corners in
ALLEGAN

(County)	Located In:	Corner Code \neq
1. Public Land Survey	T 3N R 15W	K-12
	T 3N R 15W	K-11
	T _____ R _____	_____
2. Property Controlling in Section	S _____ T _____ R _____	_____
	S _____ T _____ R _____	_____
3. Miscellaneous Property in Sec.	S _____ T _____ R _____	_____
	S _____ T _____ R _____	_____

Register of Deeds Stamp & File Number

4. Lot No. _____, Recorded Plat _____
 5. Private Claims _____

	A	B	C	D	E	F	G	H	I	J	K	L	M
2	6	5	4	3	2	1							
3													
4	7	8	9	10	11	12							
5													
6	18	17	16	15	14	13							
7													
8	19	20	21	22	23	24							
9													
10	30	29	28	27	26	25							
11													
12	31	32	33	34	35	36							
13													

I, GARY C. BILOW, in a field survey on APRIL 15, 19 91, do hereby certify that under requirements of P.A. 74, Michigan P.A. of 1970, the corner points mentioned in lines 1 and 2 above were in conformance with regulations and rules therefore as required in the current manual of survey instructions of the United States Department of the Interior, Bureau of Land Management or by a decree of a Court of Law and/or that the corner points mentioned in lines 3, 4 and 5 above were in conformance with the rules of the Michigan Board of Land Surveyors or by a Decree of a Court of Law, established, re-established, monumented, re-monumented, recovered, found as expressed below:

NOTE: Not more than 4 corners, all in the same town and range, may be recorded on this certificate.

A. Description of original monument and accessories and/or subsequent restoration:

(K-12) CORNER POST ESTABLISHED BY U.S. GOVERNMENT DEPUTY SURVEYOR C. BRITAIN, 1832. ACCESSORIES: PINE 18 S07W 1.25, W. OAK 4 N30E 1.76. FOUND NO RECORD OF PERPETUATION OR REESTABLISHMENT.

(K-11) CORNER POST ESTABLISHED BY U.S. GOVERNMENT DEPUTY SURVEYOR C. BRITAIN, 1832. ACCESSORIES: W. OAK 16 S28W 1.26, W. OAK 24 S68E 1.76. CORNER SHOWN AS 1" WOOD STAKE ON PAGE 94, FIELD BOOK 3 OF FIELD SURVEY NOTES OF UNKNOWN SURVEYOR ca. 1937 WITH THE FOLLOWING ACCESSORIES: N7°30'E 92.1' 8" TWIN W. OAK, N66°30'E 121.4' 8" B. OAK, S62°E 158.3' 8" CEDAR. CORNER RECORDED UNDER ACT 74, P.A. 1970 BY D.A. RATEKIN 4-18-1972 AS FOUND 1/2" IRON PIPE WITH 2" ANGLE IRON DRIVEN ALONG SIDE. ACCESSORIES: 18" CEDAR S65E 158.3', 12" BLACK OAK S25W 43.6', 8" TWIN OAK N852 24.9', 12" OAK WITH BRASS BM IN ROOT N60E 118.7', 2" ANGLE IRON S45W 0.25', CORNER IS IN NE CORNER OF CLUMP OF WILD CHERRIES (LCRC RECORDED IN LIBER 1, PAGE 271).

B. Description of corner evidence found and/or method applied in restoring or reestablishing corner:


(K-12) ORIGINAL POST AND ACCESSORIES NOT RECOVERED. FOUND A 1 1/2" GAS PIPE 0.44' WEST AND 0.12' NORTH OF THE PROPORTIONATE POSITION. THIS PIPE APPEARS TO HAVE BEEN ACCEPTED AND USED BY LOCAL SURVEYORS IN CONTROLLING PARTIAL SUBDIVISIONS OF SECTIONS 35 AND 36. I ACCEPTED THIS PIPE AS A CAREFUL AND FAITHFUL REESTABLISHMENT OF THE ORIGINAL CORNER AND REPLACED SAME WITH A 1/2"x36" REBAR ENCASED IN A 4" DIAMETER CONCRETE CYLINDER CAPPED WITH A CAST ALUMINUM MICHIGAN DEPARTMENT OF NATURAL RESOURCES TABLET.

(K-11) ORIGINAL POST AND ACCESSORIES NOT RECOVERED. FOUND 1/2" IRON PIPE 8" BELOW GROUND SURFACE WITH 2" ANGLE IRON ADJACENT IN ACCORD WITH ALL OF RATEKIN'S RECORD ACCESSORIES. 1937 TIE TO 8" (NOW 19") B. OAK ALSO CHECKS. ACCEPTED PIPE AS THE BEST AVAILABLE EVIDENCE OF THE ORIGINAL CORNER POSITION.

C. Description of monument for corner and accessories established to perpetuate locating the position of the corner:

(K-12) SET CONCRETE MONUMENT WITH MDNR CAP	(K-11) FOUND 1/2" IRON PIPE
S55E 27.06' SET NAIL AND MDNR TAG IN WEST FACE 14" OAK	N85W 25.49' SET NAIL AND MDNR TAG IN NORTH FACE 12" TWIN W. OAK
S70W 23.57' SET NAIL AND MDNR TAG IN SE FACE OF SOUTHERLY BOLE OF 9" TWIN OAK	N20E 79.26' SET NAIL AND MDNR TAG IN EAST FACE 11" W. OAK
N35W 17.56' SET NAIL AND MDNR TAG IN EAST FACE OF NORTHERLY BOLE OF 6" AND 10" TWIN OAK	NORTH 30' CENTERLINE OF GRAVEL SURFACE OF 126TH AVENUE
SOUTH 13.43' SET NAIL AND MDNR TAG IN EAST FACE 19" OAK (BLAZED TREES AT BASE AND BH)	S45W 43.65' SET NAIL AND MDNR TAG IN EAST FACE 16" B. OAK
	CORNER FALLS AT EAST SIDE OF A CLUMP OF CHERRY TREES. (BLAZED TREES AT BASE AND BH)

Signed by Gary C. Bilow Date 8/11/91
 Surveyor's Michigan License No. 26453

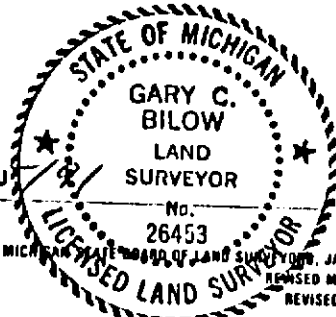

FORM APPROVED BY MICHIGAN STATE BOARD OF LAND SURVEYORS, JAN. 28, 1971
 REVISED MAY 14, 1975
 REVISED JAN., 1983