

**LAND CORNER RECORDATION CERTIFICATE**  
**Filing Requirement of Act 74, Mich. P.A. 1970**

For corners in

<u>Allegan County</u> <small>(County)</small>	Located In:	Corner Code #/
1. Public Land Survey	T _____ R _____ T _____ R _____ T _____ R _____ T _____ R _____	_____
2. Property Controlling in Section	S <u>26</u> T <u>3N</u> R <u>15W</u> S _____ T _____ R _____	<u>14, 8, 9</u>
3. Miscellaneous Property in Sec.	S _____ T _____ R _____ S _____ T _____ R _____	_____

Register of Deeds Stamp & File Number

4. Lot No. \_\_\_\_\_, Recorded Plat \_\_\_\_\_  
 5. Private Claims \_\_\_\_\_

I, Gary C. Bilow, in a field survey on \_\_\_\_\_, 19\_\_\_\_\_, do hereby certify that under requirements of P.A. 74, Michigan P.A. of 1970, the corner points mentioned in lines 1 and 2 above were in conformance with regulations and rules therefore as required in the current manual of survey instructions of the United States Department of the Interior, Bureau of Land Management or by a decree of a Court of Law and/or that the corner points mentioned in lines 3, 4 and 5 above were in conformance with the rules of the Michigan Board of Land Surveyors or by a Decree of a Court of Law, established, re-established, monumented, re-monumented, recovered, found as expressed below:

**NOTE: Not more than 4 corners, all in the same town and range, may be recorded on this certificate.**

A	B	C	D	E	F	G	H	I	J	K	L	M
2	6	5	4	3	2	1						
3												
4	7	8	9	10	11	12						
5												
6	18	17	16	15	14	13						
7												
8	19	20	21	22	23	24						
9												
10	30	29	28	27	26	25						
11												
12	31	32	33	34	35	36						
13												

A. Description of original monument and accessories and/or subsequent restoration:

B. Description of corner evidence found and/or method applied in restoring or reestablishing corner:

(14) Established in Feb. 1977 by Michigan Department of Natural Resources Surveyor Donald L. Bissell, RLS 18655, at the midpoint and on line between K-10 and K-11

(8) Establish in Feb. 1977 by Michigan Department of Natural Resources Surveyor Donald L. Bissell, RLS 18655, at midpoint and on line between I-10 and J-10, J-10 being the computed intersection of straight lines connecting opposite 1/4 corner.


(9) Corner established in Feb. 1977 by Michigan Department of Natural Resources Surveyor Donald L. Bissell, RLS 18655, at midpoint and on line between J-10 and K-10, J-10 being the computed intersection of straight lines connecting opposite 1/4 corners.

C. Description of monument for corner and accessories established to perpetuate locating the position of the corner:

(14) Set 3/4" pipe with plastic cap # 18655  
 North 26.08' spike in 10" Black Oak  
 N72°W 5.61' spike in 5" Black Oak  
 S38°E 3.67' spike in 4" White Oak

(8) Set 1/2" pipe with cap # 18655  
 S08°W 22.74' 16" Maple PK, tag & blaze  
 S56°W 37.08' 10" Maple PK, tag & blaze  
 S82°W 49.23' 10" Maple PK, tag & blaze

(9) Set 3/4" pipe with plastic cap # 18655  
 S75°E 22.83' 52" Willow PK, tag & blaze  
 S57°W 6.14' 8" Willow PK, tag & Blaze  
 N90°W 160.56' 52" Willow PK, tag & blaze  
 S57°E 33.82' Found 1 1/4" pipe

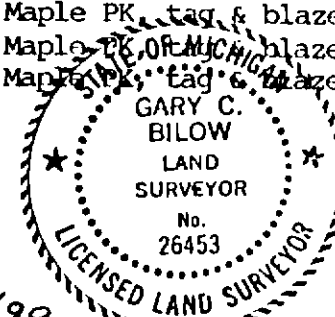

Signed by Gary C. Bilow  
 Surveyor's Michigan License No. 26453

Date 8/28/90