

LAND CORNER RECORDATION CERTIFICATE
Filing Requirement of Act 74, Mich. P.A. 1970

For corners in

<u>Allegan County</u> <small>(County)</small>	Located In:	Corner Code <i>≠</i>
1. Public Land Survey	T <u>3N</u> R <u>15W</u>	<u>K-9</u>
	T <u>3N</u> R <u>15W</u>	<u>K-10</u>
	T _____ R _____	_____
	T _____ R _____	_____
2. Property Controlling in Section	S _____ T _____ R _____	_____
	S _____ T _____ R _____	_____
3. Miscellaneous Property in Sec.	S _____ T _____ R _____	_____
	S _____ T _____ R _____	_____

Register of Deeds Stamp & File Number

4. Lot No. _____, Recorded Plat _____
 5. Private Claims _____

I, Gary C. Bilow, in a field survey on _____, 19____, do hereby certify that under requirements of P.A. 74, Michigan P.A. of 1970, the corner points mentioned in lines 1 and 2 above were in conformance with regulations and rules therefore as required in the current manual of survey instructions of the United States Department of the Interior, Bureau of Land Management or by a decree of a Court of Law and/or that the corner points mentioned in lines 3, 4 and 5 above were in conformance with the rules of the Michigan Board of Land Surveyors or by a Decree of a Court of Law, established, re-established, monumented, re-monumented, recovered, found as expressed below:

NOTE: Not more than 4 corners, all in the same town and range, may be recorded on this certificate.

A	B	C	D	E	F	G	H	I	J	K	L	M
2	6	5	4	3	2	1						
3												
4	7	8	9	10	11	12						
5												
6	18	17	16	15	14	13						
7												
8	19	20	21	22	23	24						
9												
10	30	29	28	27	26	25						
11												
12	31	32	33	34	35	36						
13												

A. Description of original monument and accessories and/or subsequent restoration:

(K-9) Post set by U.S. Government General Land Office Deputy Surveyor C. Britain, May 1832.
 Accessories: Maple 36" S23°E 28 l. - Maple 10" N19°W 14 l.

(K-10) Post set by U.S. Government General Land Office Deputy Surveyor C. Britain, May 1832.
 Accessories: Tamarack 10" S63°E 16 l. - Tamarack 9" N35°W 13 l.


B. Description of corner evidence found and/or method applied in restoring or reestablishing corner:

(K-9) Corner reestablished Feb. 1977 by Michigan Department of Natural Resources Surveyor Donald L. Bissell, RLS 18655 by single proportionate measurement based on G.L.O. record between K-8 and K-10.

(K-10) In Feb. 1977, Michigan Department of Natural Resources Surveyor Donald L. Bissell, RLS 18655, found and accepted 1 1/4" pipe in N-S fence line.

C. Description of monument for corner and accessories established to perpetuate locating the position of the corner:

(K-9) Set 1"x60" pipe with plastic cap # 18655	(K-10) Set 3/4" pipe in 1 1/4" pipe
N40°E 22.49' 14" Ash PK and blaze	S42°E 7.05' spike in 4" Elm
S60°E 14.65' 12" Ash PK and blaze	S08°W 33.24' spike in 10" Maple
S68°W 52.22' 14" Ash PK and blaze	N59°W 10.94' spike in 18" Maple
N30°W 54.83' 18" Ash PK and blaze	

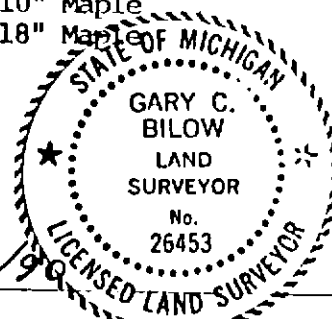

Signed by Gary C. Bilow
 Surveyor's Michigan License No. 26453

Date 8/28/90