

LAND CORNER RECORDATION CERTIFICATE
Filing Requirement of Act 74, Mich. P.A. 1970

For corners in

<u>Allegan County</u> <small>(County)</small>	Located In:	Corner Code #
1. Public Land Survey	T _____ R _____	_____
	T _____ R _____	_____
	T _____ R _____	_____
2. Property Controlling in Section	<u>26</u> T <u>3N</u> R <u>15W</u>	<u>12, 13</u>
	S _____ T _____ R _____	_____
3. Miscellaneous Property in Sec.	S _____ T _____ R _____	_____
	S _____ T _____ R _____	_____

Register of Deeds Stamp & File Number

4. Lot No. _____, Recorded Plat _____
 5. Private Claims _____

I, Gary C. Bilow, in a field survey on _____, 19____, do hereby certify that under requirements of P.A. 74, Michigan P.A. of 1970, the corner points mentioned in lines 1 and 2 above were in conformance with regulations and rules therefore as required in the current manual of survey instructions of the United States Department of the Interior, Bureau of Land Management or by a decree of a Court of Law and/or that the corner points mentioned in lines 3, 4 and 5 above were in conformance with the rules of the Michigan Board of Land Surveyors or by a Decree of a Court of Law, established, re-established, monumented, re-monumented, recovered, found as expressed below:

NOTE: Not more than 4 corners, all in the same town and range, may be recorded on this certificate.

	A	B	C	D	E	F	G	H	I	J	K	L	M
2	6	5	4	3	2	1							
3													
4	7	8	9	10	11	12							
5													
6	16	17	18	15	14	13							
7													
8	19	20	21	22	23	24							
9													
10	30	29	28	27	26	25							
11										•	•		
12	31	32	33	34	35	36							
13													

A. Description of original monument and accessories and/or subsequent restoration:

B. Description of corner evidence found and/or method applied in restoring or reestablishing corner:


(12) Established in Feb. 1977 by Michigan Department of Natural Resources Surveyor Donald L. Bissell, RLS 18655, at midpoint and on line between J-11 and J-10, J-10 being the computed intersection of straight lines connecting opposite 1/4 corners.

(13) Established in Feb. 1977 by Michigan Department of Natural Resources Surveyor Donald L. Bissell, RLS 18655, at the intersection of straight lines connecting (9) and (16) and (12) with (14), in accordance with standard BLM instructions for subdivision of regular sections, (16) being computed at the midpoint between J-11 and K-11.

C. Description of monument for corner and accessories established to perpetuate locating the position of the corner:

(12) Set 1" pipe with plastic cap
 # 18655
 S85°E 29.41' spike in 14" Cedar
 S48°W 6.20' spike in 14" Maple
 N20°E 4.40' spike in 8" Maple
 (Clump of 5)
 N79°W 10.35' spike in 4" Maple

(13) Set 1/2" pipe with plastic cap
 # 18655
 S40°W 4.50' spike in 7" Black Oak
 East 13.48' spike in 10" Black Oak
 N56°W 4.78' spike in 6" Black Oak

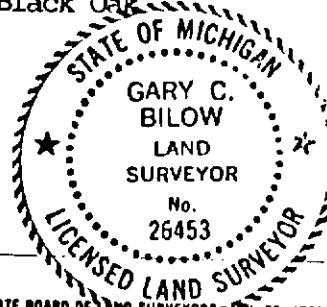

Signed by Gary C. Bilow
 Surveyor's Michigan License No. 26453

Date 8/28/90