FROM ALLEGAN DAM #1
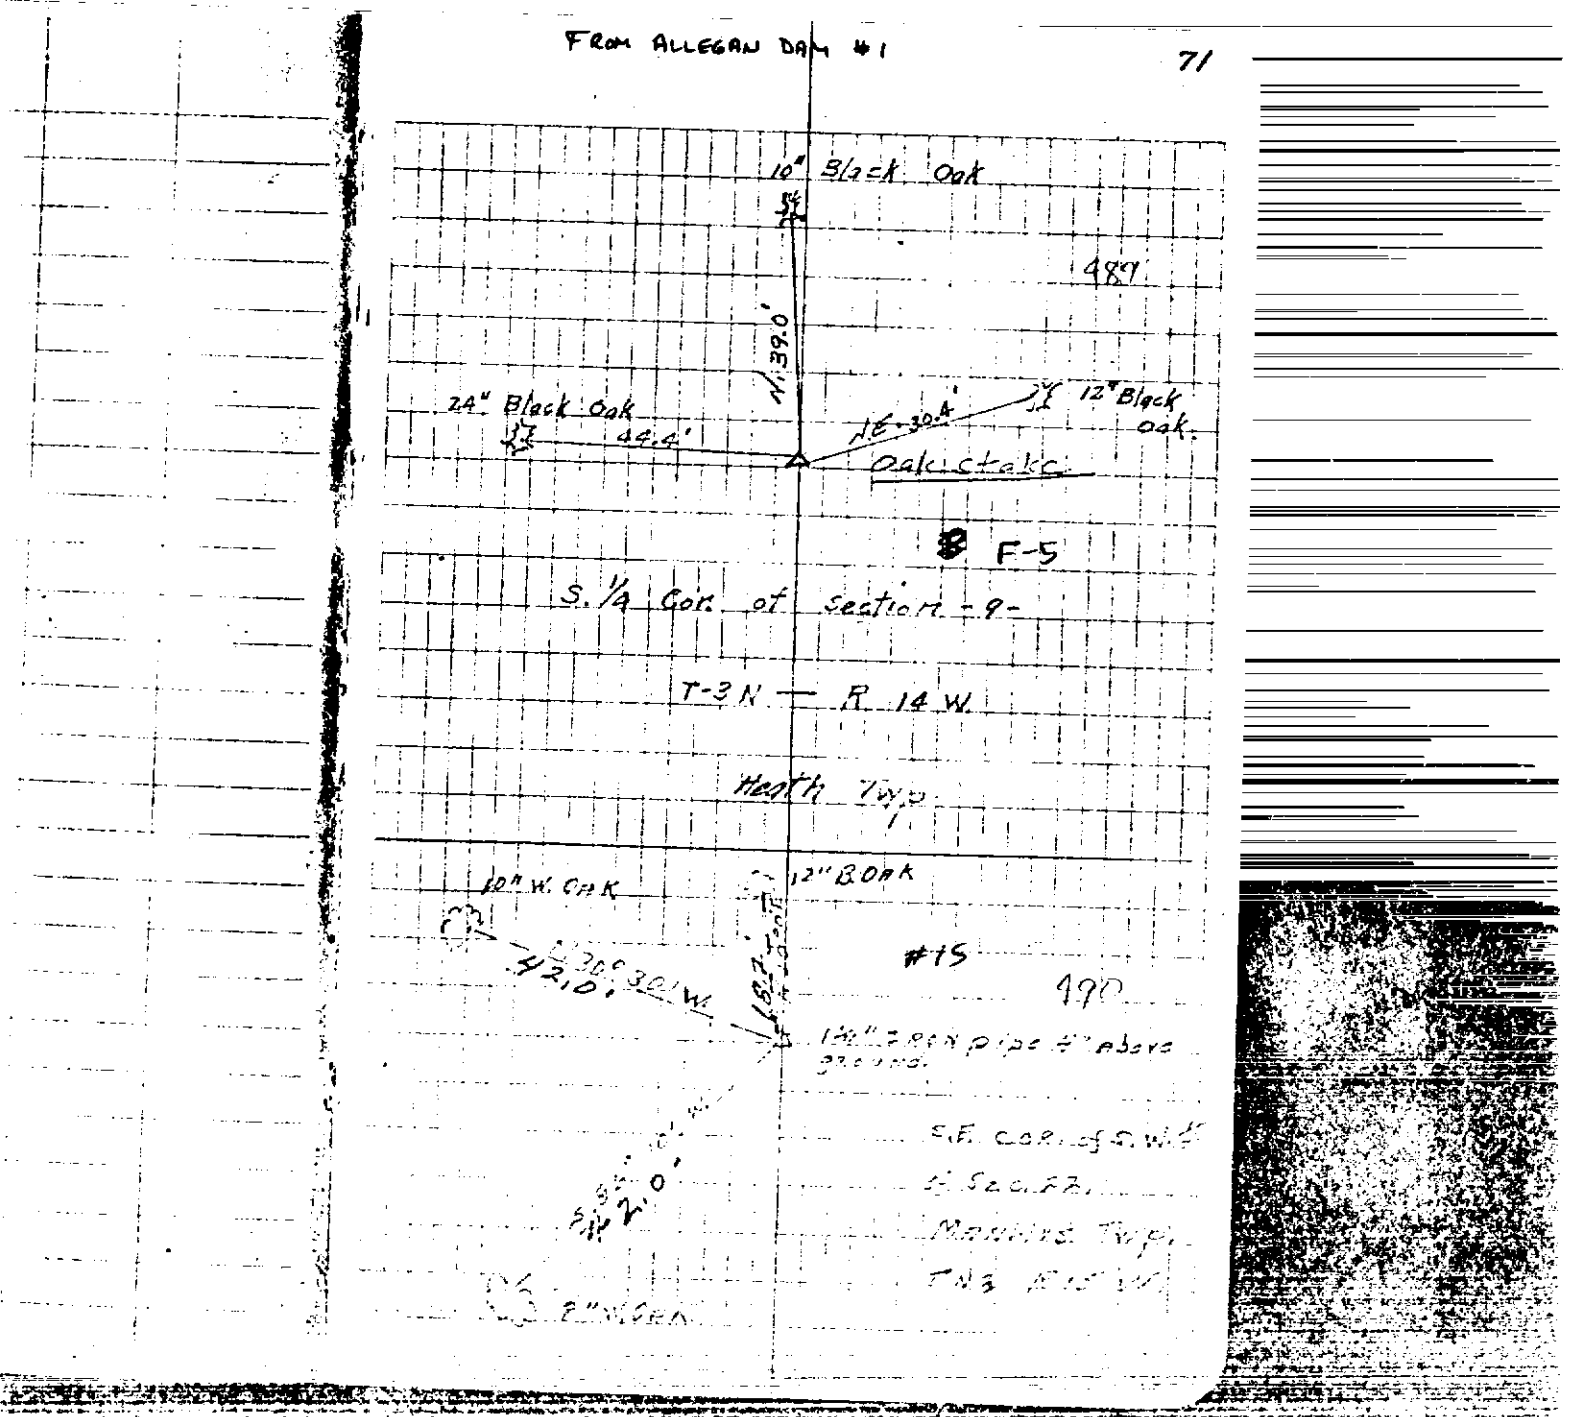
71