FROM ALLEGAN DAM #3

91°

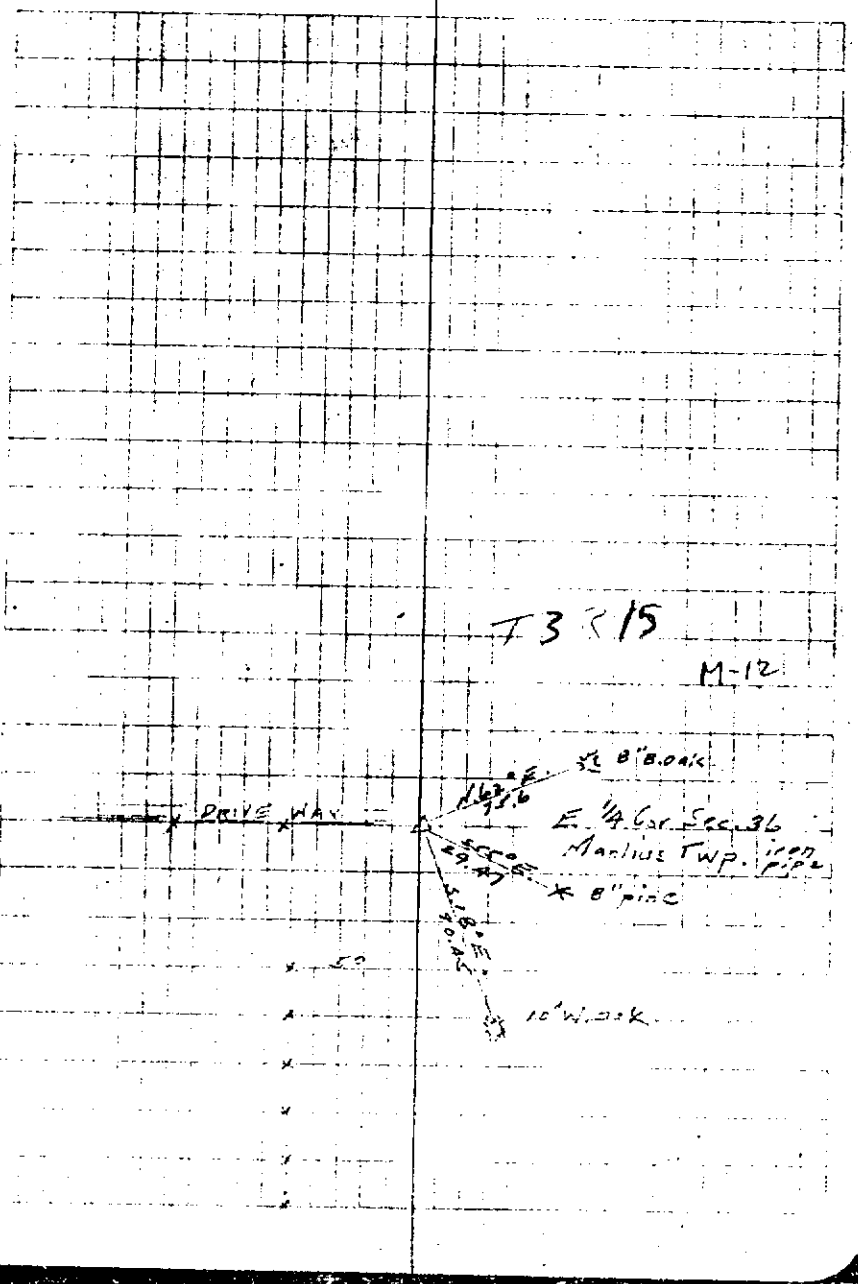

PAGE 43