


FROM ALEGAN DAM #3

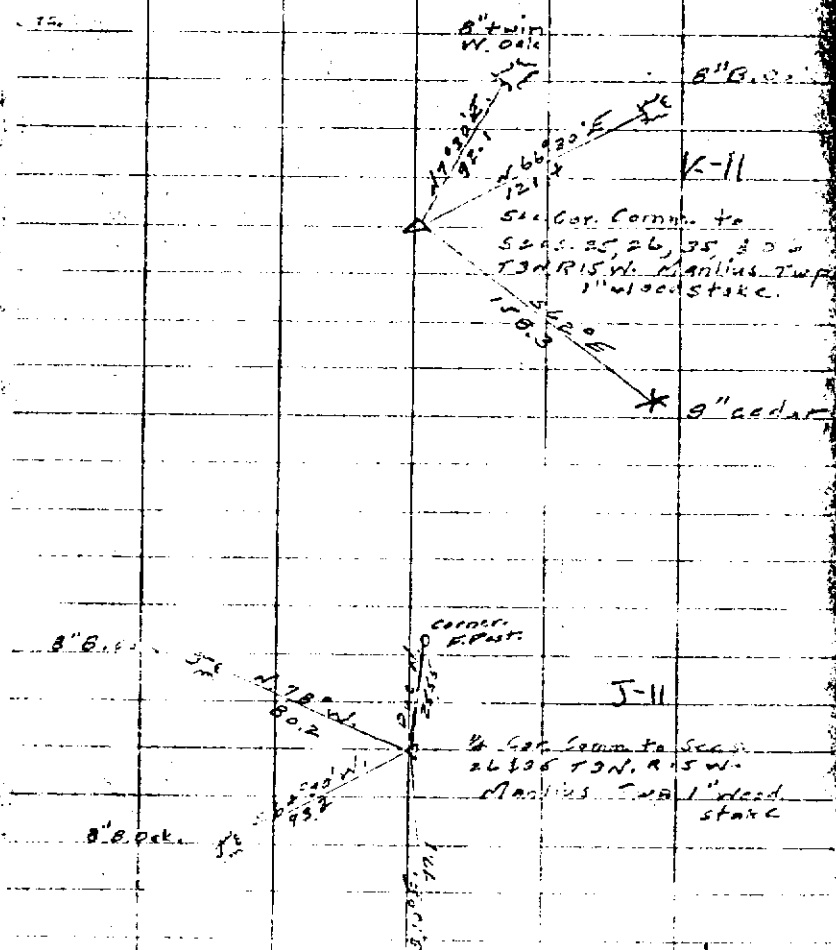

