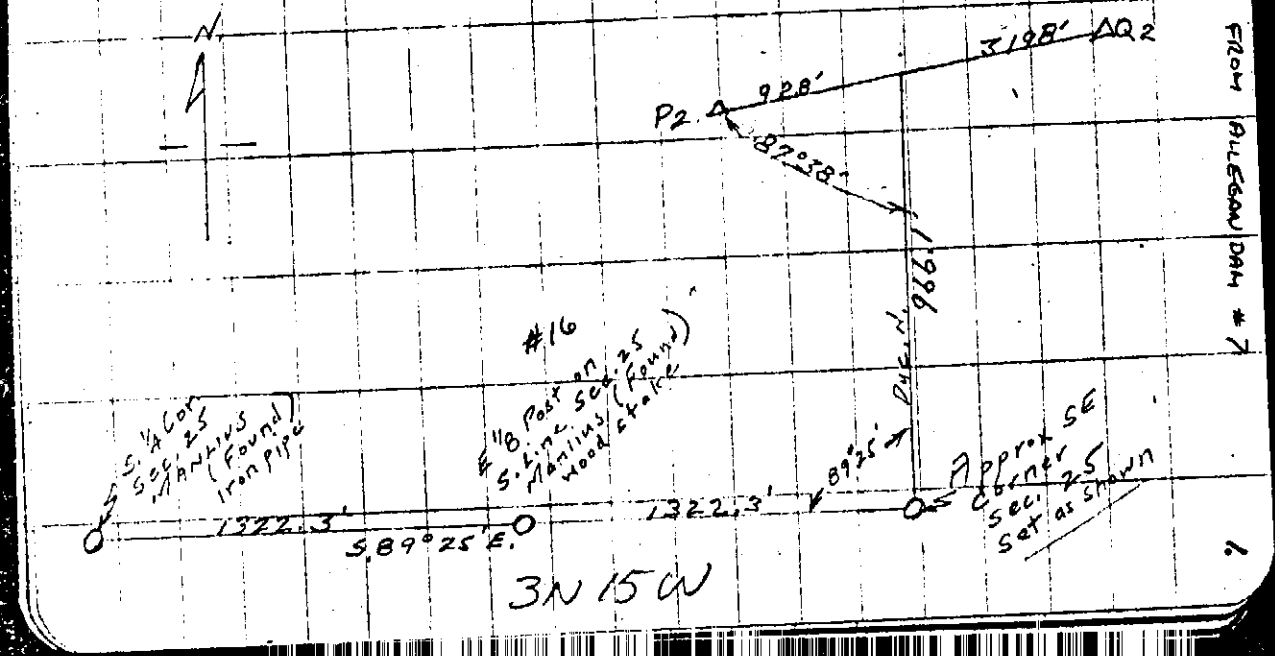OTTAWA SURVEY SEC. COR. TIE 6-24-37 H.W. Motzinger