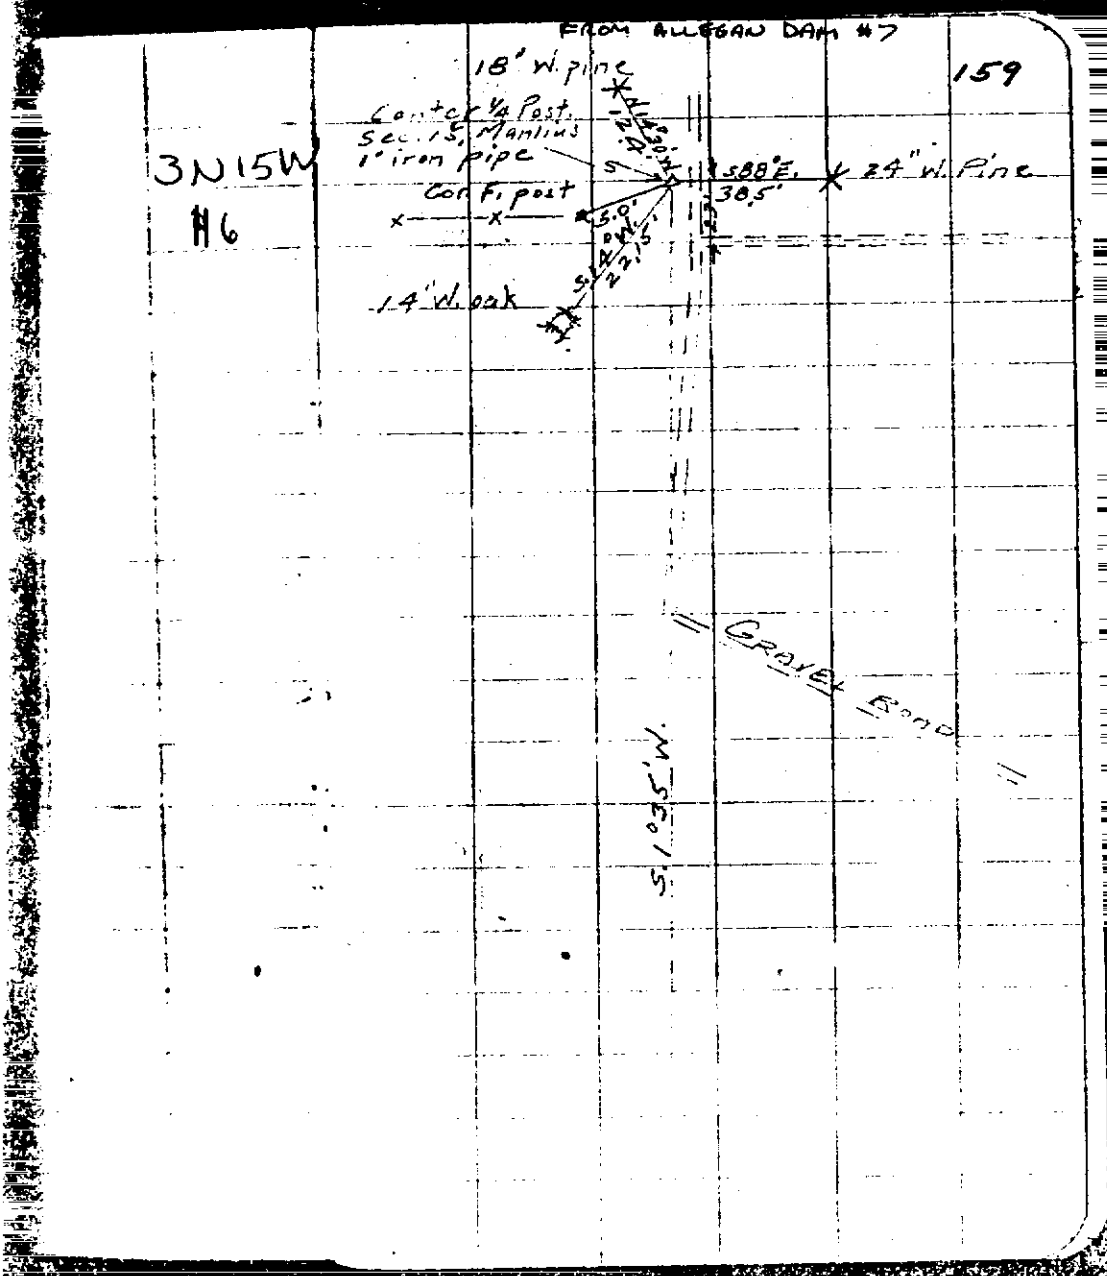
FROM ALLEGAN DAM #7
159
18" W. pine
Center 1/4 Post.
Sec. 15, Manlius
1" iron pipe
Cor. F. post
3N15W
#6
S88°E.
38.5'
24" W. Pine
14" W. oak
GRAVEL ROAD
S.1°35'W.