

MAR 07 2000

ALLEGAN COUNTY REMONUMENTATION  
LAND CORNER RECORDATION CERTIFICATE  
Filing Requirement of Act 74, Mich. P.A. 1970

REGISTER OF DEEDS  
ALLEGAN COUNTY, MICHIGAN  
*Joyce A. DeWitt*

00 FEB - 1 AM 8:43

FILED

LIBRARY / FILE 306

SECTION

For corners in  
Allegan  
(County)

Located In: Corner Code #

1. Public Land Survey T3N R15W A-11  
T R  
T R NE Corner  
T R Section 31  
2. Property Controlling S T R Manlius Twp.  
in Section S T R  
3. Miscellaneous S T R  
Property in Sec. S T R

Register of Deeds Stamp & File Number

4. Lot No. \_\_\_\_\_, Recorded Plat \_\_\_\_\_  
5. Private Claims \_\_\_\_\_

I, Steve Lampen, in a field survey on December 4, 1999, do hereby certify that under requirements of P.A. 74, Michigan P.A. of 1970, the corner points mentioned in lines 1 and 2 above were in conformance with regulations and rules therefore as required in the current manual of survey instructions of the United States Department of the Interior, Bureau of Land Management or by a decree of a Court of Law and/or that the corner points mentioned in lines 3, 4 and 5 above were in conformance with the rules of the Michigan Board of Land Surveyors or by a Decree of a Court of Law; established, re-established, monumented, re-monumented, recovered, found as expressed below:

NOTE: Not more than 4 corners, all in the same town and range, may be recorded on this certificate.

A. Description of original monument and accessories and/or subsequent restoration:

A-11 Consumers Power Co. - 1960's  
N. Brookfield - Set Post 13 Links Witnesses for SW corner Section 30  
(8.58') South of Post Power pole SW 65.3'  
Hemlock 20 N60E 43 26" Maple SW 46.0'  
Hemlock 7 S46E 31 Street sign SW 22.7'  
Tel. pole NW 78.9'

1911 - H. MacDougal - Stone  
8.6' S of Stone at M-11, T3N, R16W

R. Jonker - 1991  
Recorded Survey L-1306, P-888  
3/4" Iron in Mon  
SE Corner Section 25-3-16 N 8.62'  
PK Nail E side P. Pole S20W 65.81'  
PK Nail NW side P. Pole N50E 54.37'  
PK Nail S side P. Pole N55W 79.72'

B. Description of corner evidence found and/or method applied in restoring or reestablishing corner:

A-11 Found 3/4" Iron in Monument Box 0.07' East of East line Section 36, T3N, R16W.  
PK Nail E Side P Pole S20W 65.81'  
PK Nail NW Side P Pole N50E 54.37'  
PK Nail S Side P Pole N55W 79.72'  
36" Maple SW 46.0'  
M-11, T3N, R16W N 8.58'

Pulled iron and set standard Allegan County 3/4" x 24" iron with red cap #23520 in Monument Box on the East line of Section 36, T3N, R16W.


Approved by the Allegan County Remon Peer Group On December 14, 1999 and is accepted as a careful And faithful perpetuation of the position of the Original corner.

APPROVED REMONUMENTATION CORNER  
P.A. 345 OF 1990  
ALLEGAN COUNTY  
DATE APPROVED DEC. 14, 1999  
COUNTY REP. *[Signature]*

C. Description of monument for corner and accessories established to perpetuate locating the position of the corner:

A-11 Standard Allegan County Remonumentation 3/4" x 24" iron with red cap #23520 in Monument Box. Azimuth = Michigan State Plane grid direction.

Remonumentation tag in E side Power Pole 195° 12' 65.79'  
Remonumentation tag in N side Power Pole 119° 19' 124.67'  
Remonumentation tag in S side Power Pole 70° 21' 115.82'  
Remonumentation tag in E side Power Pole 336° 31' 118.63'  
NW Corner House, Stone 117° 43' 206.57'  
CL East and West Asphalt Road Pavement 0° 00' 5.6'  
M-11, T3N, R16W 0° 14' 8.58'

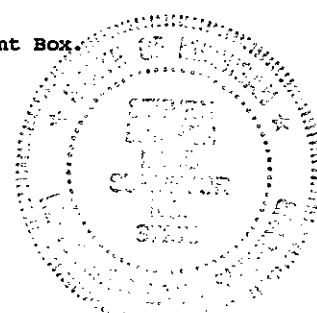

Signed by Steve Lampen Date DECEMBER 31, 1999  
Surveyor's Michigan License No. 37279