

MAR 07 2000

ALLEGAN COUNTY REMONUMENTATION  
LAND CORNER RECORDATION CERTIFICATE  
Filing Requirement of Act 74, Mich. P.A. 1970

SECTION

For corners in  
Allegan (County) Located in: Corner Code #

1. Public Land Survey T3N R15W A-12  
T R  
T R W 1/4 Corner  
T R Section 31  
2. Property Controlling S T R Manlius Twp.  
in Section S T R  
3. Miscellaneous S T R  
Property in Sec. S T R

4. Lot No. \_\_\_\_\_, Recorded Plat \_\_\_\_\_  
5. Private Claims \_\_\_\_\_

REGISTER OF RECORDS  
ALLEGAN COUNTY, MICH.  
*Joyce A. Smith*  
00 FEB -1 AM 8:48

FILED

LIBR0007 PAGE367

Register of Deeds Stamp & File Number

I, Steve Lampen, in a field survey on December 4, 1999, do hereby certify that under requirements of P.A. 74, Michigan P.A. of 1970, the corner points mentioned in lines 1 and 2 above were in conformance with regulations and rules therefore as required in the current manual of survey instructions of the United States Department of the Interior, Bureau of Land Management or by a decree of a Court of Law and/or that the corner points mentioned in lines 3, 4 and 5 above were in conformance with the rules of the Michigan Board of Land Surveyors or by a Decree of a Court of Law; established, re-established, monumented, re-monumented, recovered, found as expressed below:

NOTE: Not more than 4 corners, all in the same town and range, may be recorded on this certificate.

A. Description of original monument and accessories and/or subsequent restoration:

A-12  
Not Set By Government

B. Description of corner evidence found and/or method applied in restoring or reestablishing corner:

A-12  
No corner found.

Set standard Allegan County Remon 3/4" x 36" iron with red cap #23520 equidistant and on line with A-11 and A-13. SEE SKETCH ON BACK.


Approved by the Allegan County Remon Peer Group on December 14, 1999. This position not established by original Government surveyors. This monument is accepted as the best available evidence of the position of the corner.

APPROVED REMONUMENTATION CORNER  
P.A. 345 OF 1990  
ALLEGAN COUNTY  
DATE APPROVED DEC. 14, 1999  
COUNTY REP. *[Signature]*

C. Description of monument for corner and accessories established to perpetuate locating the position of the corner:

A-12 Standard Allegan County Remonumentation 3/4" x 36" iron with red cap #23520.  
Azimuth = Michigan State Plane grid direction.

Remonumentation tag in N side 24" Pine	281° 28'	382.50'
Remonumentation tag in S side 24" Maple	273° 52'	368.55'
Remonumentation tag in W side 24" Maple	175° 33'	492.86'
Remonumentation tag in NW side 6" Ash	232° 11'	140.54'
Cl Ditch towards the East	0° 0'	2.71'
M-12, T3N, R16W	0° 14'	4.29'

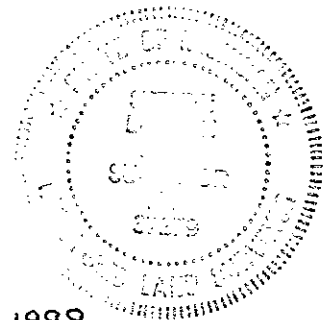

Signed by Steven Lampen

Date DECEMBER 31, 1999

Surveyor's Michigan License No. 37279



PROPERTY &  
RECORDS DIVISION

MAR 07 2000

SECTION

M A

GLO + MEAS  
8.58

11

N 0°14'03"E  
2639.77  
2635.48

SECTION 36  
T3N R16W

SECTION 31  
T3N R15W

12

N 0°14'03"E  
2639.77  
2635.48

13

LIBR0007 MAR3 68