

**SURVEY  
REMONUMENTATION**

APR 29 1999

**SECTION**

**ALLEGAN COUNTY REMONUMENTATION  
LAND CORNER RECORDATION CERTIFICATE  
Filing Requirement of Act 74, Mich. P.A. 1970**

For corners in  
Allegan  
(County)

Located In: \_\_\_\_\_ Corner Code # \_\_\_\_\_

1. Public Land Survey T3N R15W C-1  
T R  
T R  
T R  
NW corner, Section  
5, Manlius Twp.

2. Property Controlling S T R  
in Section S T R

3. Miscellaneous S T R  
Property in Sec. S T R

4. Lot No. \_\_\_\_\_, Recorded Plat \_\_\_\_\_

5. Private Claims \_\_\_\_\_

FILED  
1/28/1999 2:44:39 PM  
JOYCE A. WATTS  
REGISTER OF DEEDS  
ALLEGAN COUNTY, MICH  
**Register of Deeds Stamp & File Number**

LIBERO 006 PAGE 83

	A	B	C	D	E	F	G	H	I	J	K	L	M
1													
2	6		5		4		3		2		1		
3													
4	7		8		9		10		11		12		
5													
6	13		17		16		15		14		13		
7													
8	19		20		21		22		23		24		
9													
10	30		29		28		27		26		25		
11													
12	31		32		33		34		35		36		
13													

I, Steve Lampen, in a field survey on December 4, 1998, do hereby certify that under requirements of P.A. 74, Michigan P.A. of 1970, the corner points mentioned in lines 1 and 2 above were in conformance with regulations and rules therefore as required in the current manual of survey instructions of the United States Department of the Interior, Bureau of Land Management or by a decree of a Court of Law and/or that the corner points mentioned in lines 3, 4 and 5 above were in conformance with the rules of the Michigan Board of Land Surveyors or by a Decree of a Court of Law; established, re-established, monumented, re-monumented, recovered, found as expressed below:

**NOTE: Not more than 4 corners, all in the same town and range, may be recorded on this certificate.**

**A. Description of original monument and accessories and/or subsequent restoration:**

C-1  
GLO - Britain-Brookfield - March 8, 1832  
North between Sections 5 and 6  
81.83 North boundary 2.62 West of post  
and set corner to Sections 5 and 6  
Lynn 30 is post

Road Commission  
Irons in field  
SW 88.21 + 141.89  
Power pole NNW 28.0  
PK's in pavement to SSW on line 61.33  
+ 146.63  
172.92' W of Fillmore

**B. Description of corner evidence found and/or method applied in restoring or reestablishing corner:**

C-1 Found 1" iron in monument box 0.05 ft. North of the South line of Section 31, Town 4 North, Range 15 West, Fillmore corner East 172.92 (measured 172.96)  
Replaced 1" iron with 3/4"x24" Allegan County Remonumentation iron and cap on the South line of Section 31, Town 4 North, Range 15 West, and accepted it as a careful and faithful perpetuation of the position of the original corner.

Traversed 2645 ft. on road.


This corner was approved by the Allegan County Remonumentation Peer Group on December 8, 1998.

**APPROVED REMONUMENTATION CORNER**  
P.A. 345 OF 1990  
ALLEGAN COUNTY  
DATE APPROVED DEC. 8 1998  
COUNTY REP. [Signature]

**C. Description of monument for corner and accessories established to perpetuate locating the position of the corner:**

C-1 3/4"x24" Allegan County Remonumentation iron and cap in monument box on the South line of Section 31, Town 4 North, Range 15 W.  
Azimuth = Michigan State Plane grid direction

Power pole, remonumentation tag in NW side	63° 12'	169.74
Power pole, remonumentation tag in SW side	105° 09'	139.32
Power pole, remonumentation tag in E side	190° 04'	197.20
Power pole, remonumentation tag in NW side	32° 47'	38.78
C-13, Town 4 North, Range 15 West	90° 26'	172.96
NGS BM E 319	190° 16'	199.51

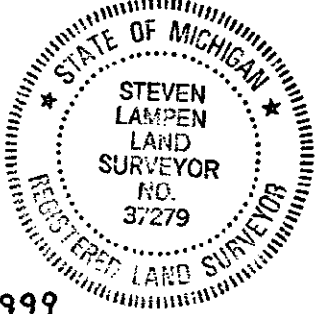

Signed by Steven Lampen Date JANUARY 11, 1999

Surveyor's Michigan License No. 37279