

SURVEY & REMONUMENTATION

APR 25 1995

COMMISSION

For corners in

Allegan

(County)

ALLEGAN COUNTY REMONUMENTATION LAND CORNER RECORDATION CERTIFICATE

Filing Requirement of Act 74, Mich. P.A. 1970

*Register of Deeds
ALLEGAN COUNTY MICHIGAN*

1994 DEC 30 PM 12:17


FILED

For corners in	Located in:	Corner Code #
1. Public Land Survey	T <u>3N</u> R <u>15W</u>	<u>F-3</u>
	T ___ R ___	<u>S 1/4 Cor.</u>
	T ___ R ___	<u>Sec. 4</u>
	T ___ R ___	<u>N 1/4 Cor.</u>
	T ___ R ___	<u>Sec. 9</u>
2. Property Controlling in Section	S ___ T ___ R ___	<u>Manlius Twp.</u>
	S ___ T ___ R ___	___
3. Miscellaneous Property in Sec.	S ___ T ___ R ___	___
	S ___ T ___ R ___	___
4. Lot No. _____, Recorded Plat _____		
5. Private Claims _____		

Register of Deeds Stamp & File Number

I, Kirk Van Order in a field survey on October 21, 19 93, do hereby certify that under requirements of P.A. 74, Michigan P.A. of 1970, the corner points mentioned in lines 1 and 2 above were in conformance with regulations and rules therefore as required in the current manual of survey instructions of the United States Department of the Interior, Bureau of Land Management or by a decree of a Court of Law and/or that the corner points mentioned in lines 3, 4 and 5 above were in conformance with the rules of the Michigan Board of Land Surveyors or by a Decree of a Court of Law; established, re-established, monumented, re-monumented, recovered, found as expressed below:

NOTE: Not more than 4 corners, all in the same town and range, may be recorded on this certificate.

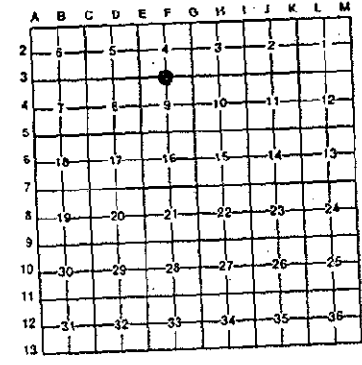

A. Description of original monument and accessories and/or subsequent restoration:

- F-3
- 40.10 W GLO set 1/4 section post
- 3" Hemlock S8°E 4 links
- 20" Beech N35°W 15 links
- T.O. Williams notes, Feb. 1889, shows stake & stone set at N 1/4 Corner, Section 9.
- 2666.40' to NE corner
- 2653.86' to NW corner
- 2659.80' to center

(Continued on back of sheet)

B. Description of corner evidence found and/or method applied in restoring or reestablishing corner:

- F-3
- Fd. 1/2" steel re-rod with cap H.E.I. in C/L of gravel road
- Old fence line to the East and West
- Power Pole E 59.81'
- 3" Elm W,NW 45.75'
- Road grade has been cut, most likely removing T.O. Williams corner stone.

And is accepted as the best available evidence of the position of the original corner.

Peer Group approved 3-9-94.

APPROVED REMONUMENTATION CORNER
P.A. 345 OF 1990
ALLEGAN COUNTY
DATE APPROVED 3-9-94
COUNTY REP. Kirk Van Order

C. Description of monument for corner and accessories established to perpetuate locating the position of the corner:

- F-3
- Replaced capped iron
- Set standard Allegan Co. Remon. monument (3/4" x 24" steel rod w/red cap #23520)
- Nail & Remon. tag in SW side 9" Basswood N,NW 97.95'
- Nail & Remon. tag in S side Power Pole E 59.77'
- Nail & Remon. tag in N side 10' Elm W 60.53'
- Nail & Remon. tag in sw side 9" Basswood NW 135.56'

Signed by [Signature] Date 12-30-94

Surveyor's Michigan License No. 23520

0005 PAGE 140

Page 1 of 2

FORM APPROVED BY MICHIGAN STATE BOARD OF LAND SURVEYORS, JAN. 28, 1971
REVISED MAY 14, 1975
REVISED JAN., 1983

Section A (continued from Page 1)

F-3

•Holland Engineering, Inc.
Set steel bar in C/L N & S road
Old fence East
Old fence West
Power Pole E 59.81'
3" Elm W,NW 45.75'

