

**SURVEY
REMONUMENTATION**

APR 29 1999

SECTION

**ALLEGAN COUNTY REMONUMENTATION
LAND CORNER RECORDATION CERTIFICATE
Filing Requirement of Act 74, Mich. P.A. 1970**

FILED

1/28/1999 2:44:39 PM

JOYCE A. MATTS
REGISTER OF DEEDS
ALLEGAN COUNTY, MICH

Register of Deeds Stamp & File Number

LIBERO 006 PAGE 486

For corners in
Allegan
(County)

Located In: Corner Code #

1. Public Land Survey T3N R15W G-1
T R
T R
T R
NW corner, Sec. 3
Manlius Twp.

2. Property Controlling S T R
in Section S T R

3. Miscellaneous S T R
Property in Sec. S T R

4. Lot No. _____ Recorded Plat _____
5. Private Claims _____

I, Steve Lampen, in a field survey on December 4, 1998, do hereby certify that under requirements of P.A. 74, Michigan P.A. of 1970, the corner points mentioned in lines 1 and 2 above were in conformance with regulations and rules therefore as required in the current manual of survey instructions of the United States Department of the Interior, Bureau of Land Management or by a decree of a Court of Law and/or that the corner points mentioned in lines 3, 4 and 5 above were in conformance with the rules of the Michigan Board of Land Surveyors or by a Decree of a Court of Law; established, re-established, monumented, re-monumented, recovered, found as expressed below:

NOTE: Not more than 4 corners, all in the same town and range, may be recorded on this certificate.

A. Description of original monument and accessories and/or subsequent restoration:

G-1 County Records
GLO - Britain-Brookfield - 1832 Found stake, set 1" iron
North between Sections 3 & 4 Power pole NW 59.63
83.62 set corner on N boundary Street sign NE 71.55
1.92 W of post Telephone pole SE 54.85
Maple 12 S 43 E 5 Centerline road S is 16' E
Black Ash 12 S 57 W 34

L.C.R.C. L2, P261 - Ratekin - 1974
Found 1" iron
Power pole N 45° W 59.63
Street sign N 75° E 71.55
Telephone pole S 55° E 54.85
Centerline road South is 16' East

B. Description of corner evidence found and/or method applied in restoring or reestablishing corner:

G-1 Found iron in monument box on the South line of Section 33, Town 4 North, Range 15 West.
Power pole NW 59.35 Centerline road South is 16' East

Replaced iron with 3/4"x24" Allegan County Remonumentation iron and cap and accepted it as a careful and faithful perpetuation of the position of the original corner.

Traversed 2615 ft. on road

This corner was approved by the Allegan County Remonumentation Peer Group on December 8, 1998.

APPROVED REMONUMENTATION CORNER

P.A. 345 OF 1990

ALLEGAN COUNTY

DATE APPROVED DEC 8, 1998


COUNTY REP. *Paul T. Lampen*

C. Description of monument for corner and accessories established to perpetuate locating the position of the corner:

G-1 3/4"x24" Allegan County Remonumentation iron and cap in monument box on the South line of Section 33, Town 4 North, Range 15 West

Azimuth = Michigan State Plane grid direction

Power pole, remonumentation tag in NW side	62° 35'	107.44
Power pole, remonumentation tag in E side	322° 25'	59.81
Guy pole, remonumentation tag in SE side	243° 25'	68.77
Power pole, remonumentation tag in NNE side	103° 54'	149.75
Centerline gravel road towards the South	90° 48'	16.00
G-13, Town 4 North, Range 15 West	90° 48'	126.85

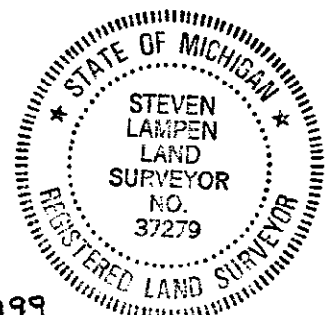

Signed by *Steven Lampen*

Date JANUARY 11, 1999

Surveyor's Michigan License No. 37279