

**SURVEY
REMONUMENTATION**

APR 29 1999

**ALLEGAN COUNTY REMONUMENTATION
LAND CORNER RECORDATION CERTIFICATE
Filing Requirement of Act 74, Mich. P.A. 1970**

FILED

SECTION

1/28/1999 2:44:39 PM

For corners in
Allegan
(County)

Located in: _____ Corner Code # _____

1. Public Land Survey T 3N R 15W H-1
T _____ R _____
T _____ R _____
T _____ R _____
North 1/4 cor

2. Property Controlling S _____ T _____ R _____
in Section S _____ T _____ R _____ Section 3
T3N R15W

3. Miscellaneous S _____ T _____ R _____
Property in Sec. S _____ T _____ R _____
Manlius Twp.

4. Lot No. _____, Recorded Plat _____

5. Private Claims _____

LIBR00006 PAGE 87

JOYCE A. WATTS
REGISTER OF DEEDS
ALLEGAN COUNTY, MICH

Register of Deeds Stamp & File Number

I, Steve Lampen _____, in a field survey on December 4, 1998, do hereby certify that under requirements of P.A. 74, Michigan P.A. of 1970, the corner points mentioned in lines 1 and 2 above were in conformance with regulations and rules therefore as required in the current manual of survey instructions of the United States Department of the Interior, Bureau of Land Management or by a decree of a Court of Law and/or that the corner points mentioned in lines 3, 4 and 5 above were in conformance with the rules of the Michigan Board of Land Surveyors or by a Decree of a Court of Law; established, re-established, monumented, re-monumented, recovered, found as expressed below:

NOTE: Not more than 4 corners, all in the same town and range, may be recorded on this certificate.

A. Description of original monument and accessories and/or subsequent restoration:

H-1	CP Co.	County Records	LCRC-L2 P261 Ratekin 1974
GLO-corner	Set Iron	3/4" Iron set	Found 3/4 Iron
Not set by GLO	H-1 → H-13, T4N R15W = 105.6	24" Maple NE 46.21	24" Maple N35°E 46.21
	H-1 on line between	St. sign NE 26.45	Tel Pole S45°W 38.61
	G-13, T.4N R.15W and I-1	P.P. NW 88.51	Power Pole N70°W 88.51
		TP SW 38.61	
		Corner set mid-way	
		And on line	

Survey by VanOrder 1991

Found Iron in Mon Box
Tel. Pole SW 41.26
Power Pole NW 89.15
SE corner Brick House N 94.12
10" Maple SE 49.88

B. Description of corner evidence found and/or method applied in restoring or reestablishing corner:

H-1 Found 3/4" iron in monument box 0.28' South of South line Section 34, Town 4 North, Range 15 West
H-1 to h-13 measured 105.38 H-1 to G-1 measured 2670.68 H-1 to I-1 measured 2671.17
Telephone pole SW 40.83 SE corner brick house N 94.10

Set a 3/4"x24" Allegan County Remonumentation iron and cap on the South line of Section 34, Town 4 North, Range 15 West. This corner was not monumented by the original GLO Survey. This position is accepted as the Best available evidence of the position of the corner.

Traversed 2649 ft. on road


This corner was approved by the Allegan County Remonumentation Peer Group on December 8, 1998.

APPROVED REMONUMENTATION CORNER
P.A. 345 OF 1990
ALLEGAN COUNTY
DATE APPROVED DEC. 8, 1998
COUNTY REP. *[Signature]*

C. Description of monument for corner and accessories established to perpetuate locating the position of the corner:

H-1 3/4"x24" Allegan County Remonumentation iron and cap in monument box on the South line of Section 34, Town 4 North, Range 15 West
Azimuth = Michigan State Plane grid direction

Power pole, remonumentation tag in SE side	218° 05'	41.48
16" Ash, remonumentation tag in SW side	123° 23'	69.72
SE corner house, brick	4° 48'	93.84
SW corner house, brick	339° 34'	100.91
Power pole, remonumentation tag in NNE side	305° 53'	85.42
H-13, Town 4 North, Range 15 West	90° 59'	105.37

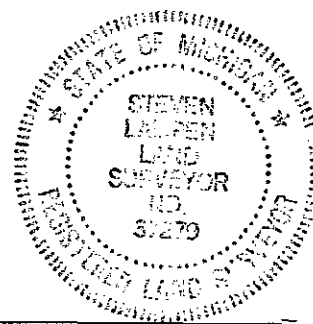

Signed by Steven Lampen

Date JANUARY 11, 1999

Surveyor's Michigan License No. 37279