

**SURVEY  
REMONUMENTATION**

APR 29 1999

**SECTION**

**ALLEGAN COUNTY REMONUMENTATION  
LAND CORNER RECORDATION CERTIFICATE  
Filing Requirement of Act 74, Mich. P.A. 1970**

For corners in <u>Allegan</u> (County)	Located In:	Corner Code #
1. Public Land Survey	T <u>3N</u> R <u>15W</u>	L-1
	T _____ R _____	
	T _____ R _____	North 1/4 corner
	T _____ R _____	Section 1
2. Property Controlling in Section	S _____ T _____ R _____	Manlius Twp.
	S _____ T _____ R _____	
3. Miscellaneous Property in Sec.	S _____ T _____ R _____	
	S _____ T _____ R _____	

FILED

1/28/1999 2:44:39 PM

JOYCE A. WATTS  
REGISTER OF DEEDS  
ALLEGAN COUNTY, MICH

LIBR0006 PAGE 90

Register of Deeds Stamp & File Number

4. Lot No. \_\_\_\_\_, Recorded Plat \_\_\_\_\_  
5. Private Claims \_\_\_\_\_

I, Steve Lampen, in a field survey on December 4, 1998, do hereby certify that under requirements of P.A. 74, Michigan P.A. of 1970, the corner points mentioned in lines 1 and 2 above were in conformance with regulations and rules therefore as required in the current manual of survey instructions of the United States Department of the Interior, Bureau of Land Management or by a decree of a Court of Law and/or that the corner points mentioned in lines 3, 4 and 5 above were in conformance with the rules of the Michigan Board of Land Surveyors or by a Decree of a Court of Law; established, re-established, monumented, re-monumented, recovered, found as expressed below:

**NOTE:** Not more than 4 corners, all in the same town and range, may be recorded on this certificate.

**A. Description of original monument and accessories and/or subsequent restoration:**

L-1	County Records - 1958	Survey - L 1057 P713-WanOrder 1983
GLO - corner	Set 1" Iron	Power Pole NNW 35.35
Not set by GLO	P.P. NNW 35.2	Fillmore Cor. W 10.15
	12" Walnut SSE 31.2	16" Walnut SSE 31.05
	Iron S 33	NE cor RSE SW 107.45

LCRC-LH P408-Greer-1994  
Found iron pipe in mon box  
Tel. Pole S76°E 135.46  
24" Walnut S 6°E 31.57  
Tel. Pole S69°W 89.03  
Power Pole N16°W 35.75  
Iron (L-13, T4N R.15W)W 10.11

	A	B	C	D	E	F	G	H	I	J	K	L	M
1													
2	6	5	4	3	2	1							
3													
4	7	8	9	10	11	12							
5													
6	18	17	16	15	14	13							
7													
8	19	20	21	22	23	24							
9													
10	30	29	28	27	26	25							
11													
12	31	32	33	34	35	36							
13													

**B. Description of corner evidence found and/or method applied in restoring or reestablishing corner:**

L-1 Found 3/4" iron in monument box on South line of Section 36, Town 4 North, Range 15 West  
Power pole NNW 35.2  
Iron W 10.15  
NE corner house SW 107.45  
Telephone pole S 76° E 135.46  
Telephone pole S 69° W 89.03

APPROVED REMONUMENTATION CORNER  
P.A. 345 OF 1990  
ALLEGAN COUNTY  
DATE APPROVED DEC. 8, 1998  
COUNTY REP. *[Signature]*

Replaced iron with 3/4" Allegan County Remonumentation iron and cap.

This corner was not monumented by the original GLO Survey. This position is accepted as the best available evidence of the position of the corner.


Traversed 2634 ft. on road.

This corner was approved by the Allegan County Remonumentation Peer Group on December 8, 1998.

**C. Description of monument for corner and accessories established to perpetuate locating the position of the corner:**

L-1 3/4"x24" Allegan County Remonumentation iron and cap in monument box  
Azimuth = Michigan State Plane grid direction

Power pole remonumentation tag E side	346°	58'	35.77
SW corner house, brick	132°	36'	137.01
NE corner house, brick	168°	43'	121.67
NE corner house, brick	190°	07'	110.85
NW corner house, brick	224°	08'	122.70
L-13, Town 4 North, Range 15 West	271°	32'	10.15

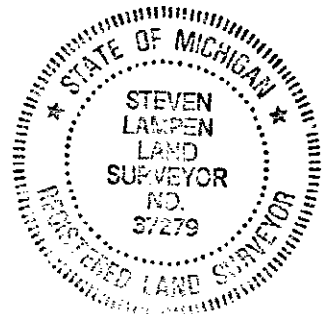

Signed by Steven Lampen

Date JANUARY 11, 1999

Surveyor's Michigan License No. 37279