

RECORDED  
MAR 07 2000

ALLEGAN COUNTY REMONUMENTATION  
LAND CORNER RECORDATION CERTIFICATE  
Filing Requirement of Act 74, Mich. P.A. 1970

REGISTER OF DEEDS  
ALLEGAN COUNTY, MICH.  
00 FEB - 1 AM 8:48  
FILED  
INDEXED 007 PAGES 69

For corners in Allegan SECTION \_\_\_\_\_ Located In: \_\_\_\_\_ Corner Code # \_\_\_\_\_  
(County)

1. Public Land Survey T 3N R 15W M-11  
T \_\_\_\_\_ R \_\_\_\_\_ Manlius Twp.  
T \_\_\_\_\_ R \_\_\_\_\_  
T \_\_\_\_\_ R \_\_\_\_\_

2. Property Controlling S \_\_\_\_\_ T \_\_\_\_\_ R \_\_\_\_\_  
in Section S \_\_\_\_\_ T \_\_\_\_\_ R \_\_\_\_\_

3. Miscellaneous S \_\_\_\_\_ T \_\_\_\_\_ R \_\_\_\_\_  
Property in Sec. S \_\_\_\_\_ T \_\_\_\_\_ R \_\_\_\_\_

4. Lot No. \_\_\_\_\_, Recorded Plat \_\_\_\_\_  
5. Private Claims \_\_\_\_\_

Register of Deeds Stamp & File Number

I, Kirk L Van Order in a field survey on Oct 18, 1999 do hereby state that under requirements of P.A. 74, Michigan P.A. of 1970, the corner points mentioned in lines 1 and 2 above were in conformance with regulations and rules therefore as required in the current manual of survey instructions of the United States Department of the Interior, Bureau of Land Management or by a decree of a Court of Law and/or that the corner points mentioned in lines 3, 4 and 5 above were in conformance with the rules of the Michigan Board of Land Surveyors or by a Decree of a Court of Law; established, re-established, monumented, recovered, found as expressed below:

NOTE: Not more than 2 corners, all in the same town and range, may be recorded on this certificate.

A	B	C	D	E	F	G	H	I	J	K	L	M
1												
2	6	5	4	3	2	1						
3												
4	7	8	9	10	11	12						
5												
6	18	17	16	15	14	13						
7												
8	19	20	21	22	23	24						
9												
10	30	29	28	27	26	25						
11												
12	31	32	33	34	35	36						
13												

A. Description of original monument and accessories and/or subsequent restoration:

M-11  
(1) GLO North East side Sec. 36  
80.00' set post corner Sections 25 & 36  
B. oak 8 N.20°W. 90  
B. oak 8 S.34°W. 471  
U.S. Government Deputy Surveyor L. Lyon, 1832

APPROVED REMONUMENTATION CORNER  
P.A. 345 OF 1990  
ALLEGAN COUNTY  
DATE APPROVED Nov. 9, 1999  
COUNTY REP. [Signature]

(continued on back of sheet)

B. Description of corner evidence found and/or method applied in restoring or reestablishing corner:


M-11  
Fd. 4" dia. concrete monument with MDNR aluminum cap and the following witnesses:  
N.83°W. 42.63' (M-42.61') MDNR tag & nail in N. face W. Pine  
N.42°W. 48.62' (M-48.57') MDNR tag & nail in E. face W. Oak  
East 18.86' MDNR tag & nail in N. face W. Oak  
N.30°E. 23.76' (M-23.74') MDNR tag & nail in SE face W. Oak  
South 16' (M-15'+/-) C/L gravel surface 126th Ave.

And is accepted as a careful and faithful perpetuation of the position of the original corner.  
Peer group approved Nov. 9, 1999.

C. Description of monument for corner and accessories established to perpetuate locating the position of the corner:

M-11  
4" dia. concrete monument w/MDNR aluminum cap  
Nail & Remon. tag in SW side 8" w. oak AZ 330° 37.20'  
Nail & Remon. tag in E side 8" cherry AZ 05° 27.76'  
Nail & Remon. tag in NW side w. oak AZ 75° 45.04'  
Nail & Remon. tag in SW side 24" b. oak AZ 130° 69.88'  
C/L sand road 126th Ave. AZ 180° 15'+/-

Signed by [Signature]  
Surveyor's Michigan License No. 23520

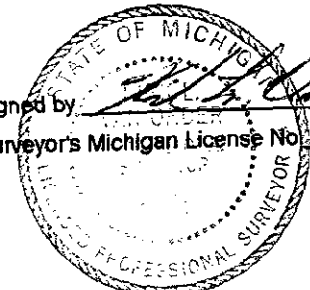

Date 12-30-1999.

RECEIVED  
MAR 07 2000

MAR 07 2000

SECTION

LIBR0007 MAR3 70

Section A (continued from Page 1)

M-11

Manlius Twp., T.3N., R.15W.

- (2) Old survey dated May 18, 19 & 20, 1893 show stake at corner  
2643 1/4' to N. 1/4 corner  
2627' to E. 1/4 corner
- (3) Donald A. Ratekin Section 36, Manlius Twp., T.3N., R.15W.  
Section drawing shows 2645.11' to N. 1/4 corner and 5125.20' to SE  
corner
- (4) LCRC recorded in L. 004, P. 137, by Gary C. Bilow, dated Aug. 15, 1991  
Set concrete monument with MDNR cap  
N.93°W. 42.63' Set nail & MDNR tag in N. face 4" pine  
N.42°W. 48.62' Set nail & MDNR tag in E. face 6" w. oak  
East 13.86' Set nail & MDNR tag in N. face 13" w. oak  
N.30°E. 23.76' Set nail & MDNR tag in E. face 7" w. oak  
S.16' C/L of gravel surface of 126th Ave.
- (5) Wightman-Moored corner info. card  
Same as in No. 4
- (6) Holland Engineering info.  
Same as in No. 4