

RE

MAR 07 2000

SECTION

ALLEGAN COUNTY REMONUMENTATION
LAND CORNER RECORDATION CERTIFICATE
Filing Requirement of Act 74, Mich. P.A. 1970

REGISTER OF DEEDS
ALLEGAN COUNTY, MICH.
Jasper L. ...

00 FEB - 1 AM 8:50

FILED
LINDA ...

For corners in Allegan (County) Located in: Corner Code #
1. Public Land Survey T3N R16W E-12
2. Property Controlling in Section S T R W 1/4 Corner Section 33 Saugatuck Twp.
3. Miscellaneous Property in Sec. S T R
4. Lot No. Recorded Plat
5. Private Claims

Register of Deeds Stamp & File Number

Table with 12 rows and 13 columns (A-M) containing numbers 1-36 in a grid pattern.

I, Donald R. Pitts, Jr., in a field survey on December 11, 1999, do hereby certify that under requirements of P.A. 74, Michigan P.A. of 1970, the corner points mentioned in lines 1 and 2 above were in conformance with regulations and rules therefore as required in the current manual of survey instructions of the United States Department of the Interior, Bureau of Land Management or by a decree of a Court of Law and/or that the corner points mentioned in lines 3, 4 and 5 above were in conformance with the rules of the Michigan Board of Land Surveyors or by a Decree of a Court of Law; established, re-established, monumented, re-monumented, recovered, found as expressed below:

NOTE: Not more than 4 corners, all in the same town and range, may be recorded on this certificate.

A. Description of original monument and accessories and/or subsequent restoration:

E-12
1831 - C. Britain 1972 - D. Ratekin - LCRC L-1, P-320 1973 - G. Mitchell
Beech 9 S89W 27 Found 1 1/2" Solid Iron Recorded Survey L-839, P-378
Beech 20 N68E 10 Part "A" Tel Cable Box N80W 38.80'
Old Notes - Iron 36" Maple N45W 96.70'
24" Maple NNW 99.5' 36" Maple S10E 168.50'
Tel Pole W 38.6'
Tel Pole SSW 120.5'
County Surveyors Records Part "C"
Stone - No witnesses 1 1/2" Solid Iron CL Road 1' W
Tel Cable Outlet Box SE Corner N75W 38.55'
26" Maple N35W to PK Nail in NE Side 99.67'
1/4" Iron E 33.00'
Mail Box S70E 22.0' (2X2X8's Nailed for Post)

CONTINUED ON REVERSE SIDE

B. Description of corner evidence found and/or method applied in restoring or reestablishing corner:

E-12 Found Pinched Iron in Monument Box.
Tel Cable Outlet Box SE Corner N75W 38.55'
PK Nail NE Side 26" Maple N35W 99.67'
PK Nail in 14" Maple E 37.97'
8" Sassafras N82W 53.00'
Fc Post S45W 35.00'
1/4" Iron E 33.00'
Mail Box (2X2X8's Nailed for Post) S70E 22.00'
Centerline Road W 0.5'
Centerline Drive S 10.5'

APPROVED REMONUMENTATION CORNER
P.A. 345 OF 1990
ALLEGAN COUNTY


DATE APPROVED DEC. 14, 1999
COUNTY REP. [Signature]

Replaced pipe with an Allegan County Remonumentation iron and cap and accepted it as a careful and faithful perpetuation of the position of the original corner.

Approved by the Allegan County Remonumentation Peer Group on December 14, 1999.

C. Description of monument for corner and accessories established to perpetuate locating the position of the corner:

E-12 Standard Allegan County Remonumentation 1/4" x 24" iron with red cap #23520 in Monument Box.
Azimuth = Michigan State Plane grid direction.
Remonumentation tag in W side 12" Maple 143° 16' 75.53'
Remonumentation tag in S side 10" Maple 89° 35' 37.92'
Remonumentation tag in SE side 8" Tri Maple 43° 06' 97.30'
Remonumentation tag in S side 24" Tw Maple 313° 45' 122.75'
Remonumentation tag in S side 6" Sassafras 283° 37' 53.11'
Remonumentation tag in E side 10" Power Pole 203° 19' 159.52'

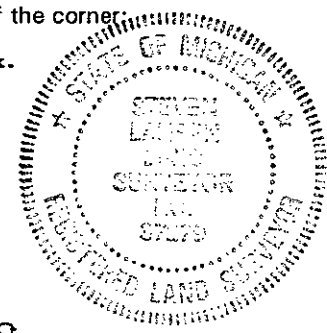

Signed by Steven Lampen

Date DECEMBER 31, 1999

Surveyor's Michigan License No. 25867

APR 07 2000

SECTION

A. Description of original monument and accessories and/or subsequent restoration:

1996 - M. Freehling

Found Iron in Monument Box		
PK in Power Pole	N80W	38.91'
PK in 14" Maple	E	37.97'
Centerline Road	W	0.5'
Centerline Drive	S	10.5'

1998 - B. Jones

Found 1" Pinch Iron in Monument Box		
N80W	TCB	39.11'
N88E	11" Oak	37.91'
S45W	Fc Post	35.00'
N82W	8" Sassafras	53.00'

RECORDED 7 MAR 30