

MAR 07 2000

SECTION

ALLEGAN COUNTY REMONUMENTATION
LAND CORNER RECORDATION CERTIFICATE
Filing Requirement of Act 74, Mich. P.A. 1970

00 FEB - 1 AM 8:50
REGISTER OF DEEDS
ALLEGAN COUNTY, MICHIGAN

LIBR0007 PAGE 31
FILED

For corners in Allegan (County) Located in: Corner Code #
1. Public Land Survey T3N R16W F-11
2. Property Controlling in Section S T R
3. Miscellaneous Property in Sec. S T R
4. Lot No. Recorded Plat
5. Private Claims

Register of Deeds Stamp & File Number

I, Steve Lampen, in a field survey on December 11, 1999, do hereby certify that under requirements of P.A. 74, Michigan P.A. of 1970, the corner points mentioned in lines 1 and 2 above were in conformance with regulations and rules therefore as required in the current manual of survey instructions of the United States Department of the Interior, Bureau of Land Management or by a decree of a Court of Law and/or that the corner points mentioned in lines 3, 4 and 5 above were in conformance with the rules of the Michigan Board of Land Surveyors or by a Decree of a Court of Law; established, re-established, monumented, re-monumented, recovered, found as expressed below:

NOTE: Not more than 4 corners, all in the same town and range, may be recorded on this certificate.

A. Description of original monument and accessories and/or subsequent restoration:

F-11
GLO - C. Britain - 1831 - Set Post
Red Oak 30 N36E 10
Beech 16 S20E 17
Gardner - 1880 - Wit.
D.A. Ratekin - 1973 - LCRC L-2, P-238
Found 1" square bolt
Power Pole S 61.8'
NE Corner House S05W 126.73'
NE Corner Tel Outlet S07W 35.47'
SW Corner Tel Switch Box on Pole N20W 30.30'

K. Van Order - 1983
Recorded Survey L-1057, P-727
Found 1" Square Bolt
Power Pole S 61.28'
NE Corner House S05W 126.73'
NE Corner Tel Outlet S07W 35.47'
SW Corner Tel Switch Box on Pole N20W 30.30'

G. Mitchell - 1995
Found 1" Square Iron
PK in Power Pole S 62.45'
NE Corner House S20W 126.73'
Nail 10" Ash N40E 35.23'
Nail 5" Tri Ash S50E 44.43'

M. Freehling - 1996 - Found Sq Iron
Nail 10" Poplar N22E 35.22'
CL Cable Ped N10E 33.58'
PK 6" Sassafras S45E 44.41'
PK Power Pole S 62.44'

B. Description of corner evidence found and/or method applied in restoring or reestablishing corner:

F-11 Found 1" Square Iron in Monument Box.
Power Pole S 62.44'
NE Corner House S05W 126.73'
NE Corner Tel Outlet S07W 35.47'
Nail in 10" Ash N40E 35.23'
Nail in 5" Tri Ash S50E 44.43'
CL Cable Ped N10E 33.58'


APPROVED REMONUMENTATION CORNER
P.A. 345 OF 1990
ALLEGAN COUNTY
DATE APPROVED DEC. 14, 1999
COUNTY REP. [Signature]

Replaced 1" Square Iron with an Allegan County Remonumentation iron and cap and accepted it as a careful and faithful perpetuation of the position of the original corner.

Approved by the Allegan County Remonumentation Peer Group on December 14, 1999.

C. Description of monument for corner and accessories established to perpetuate locating the position of the corner:

F-11 Standard Allegan County Remonumentation 1/4" x 24" iron with red cap #23520 in Monument Box.
Azimuth = Michigan State Plane grid direction.
Remonumentation tag in E side Power Pole 179° 24' 62.44'
Remonumentation tag in E side 18" Ash 322° 49' 78.25'
NE Corner House Foundation 185° 04' 126.75'
NW Corner House Foundation 201° 35' 140.14'

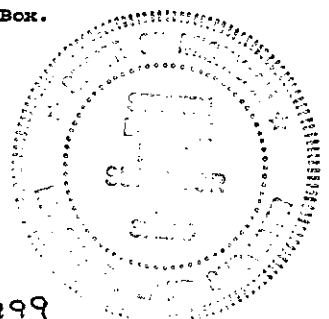

Signed by Steven Lampen Date DECEMBER 31, 1999

Surveyor's Michigan License No. 37279