

MAR 07 2000

SECTION

ALLEGAN COUNTY REMONUMENTATION
LAND CORNER RECORDATION CERTIFICATE
Filing Requirement of Act 74, Mich. P.A. 1970

James W. Ratekin
REGISTER OF DEEDS
ALLEGAN COUNTY, MICH.

00 FEB - 1 AM 8:50

RECORDED 07 PAGE 32
FILED

For corners in
Allegan
(County)

Located In: Corner Code #

1. Public Land Survey T3N R16W F-12
T R
T R
T R
Center of Section
Section 33
Saugatuck Twp.

2. Property Controlling S T R
in Section S T R
3. Miscellaneous S T R
Property in Sec. S T R

4. Lot No. _____ Recorded Plat _____

5. Private Claims _____

Register of Deeds Stamp & File Number

I, Steve Lampen, in a field survey on December 4, 1999, do hereby certify that under requirements of P.A. 74, Michigan P.A. of 1970, the corner points mentioned in lines 1 and 2 above were in conformance with regulations and rules therefore as required in the current manual of survey instructions of the United States Department of the Interior, Bureau of Land Management or by a decree of a Court of Law and/or that the corner points mentioned in lines 3, 4 and 5 above were in conformance with the rules of the Michigan Board of Land Surveyors or by a Decree of a Court of Law; established, re-established, monumented, re-monumented, recovered, found as expressed below:

NOTE: Not more than 4 corners, all in the same town and range, may be recorded on this certificate.

A. Description of original monument and accessories and/or subsequent restoration:

- F-12
GLO -
Not set by Government 1973 - D. Ratekin
LCRC L-2, P-235
Found Iron Bar
- 1880 - A. Gardner
Stone - No witnesses Same witnesses as L-840, P-496
- 1973 - D Ratekin
Recorded Survey L-840, P-496
4' x 4' Stone S65E 6.0' Iron Bar
2 1/2" Hickory E 14.09' to nail Same witnesses as L-840, P-496

B. Description of corner evidence found and/or method applied in restoring or reestablishing corner:

F-12 Did not find iron. Reset corner by using the record distance of Ratekin - E-12 to F-12 = 2627.66'
F-11 to F-12 = 2621.76' L-840, P-496
Face 4' x 4' rock 35° 2.40'
Intersection of 1/4 lines = 0.34' South and 1.55' West.

Set standard Allegan County 3/4" x 24" Remon iron with red cap #23520.
Approved by the Allegan County Remon Peer Group on December 14, 1999.
This position not established by original Government Surveyors. This Monument is accepted as the best available evidence of the position of the corner.

See sketch on back.

Traversed 10,489 feet off Road.


APPROVED REMONUMENTATION CORNER
FEB 14 1999
ALLEGAN COUNTY
DATE APPROVED DEC. 14, 1999
COUNTY REP. *James W. Ratekin*

C. Description of monument for corner and accessories established to perpetuate locating the position of the corner:

F-12 Standard Allegan County 3/4" x 24" Remonumentation iron with red cap #23520.
Azimuth = Michigan State Plane grid direction.

Remonumentation tag in SW side 3" Pine	294° 24'	89.66'
Remonumentation tag in NW side 3" Pine	49° 14'	47.02'
Remonumentation tag in N side 3" Ash	94° 10'	12.85'
Face 4' x 4' Rock	35° 00'	2.40'
East and West Field Line	0° 0'	0'

Intersection of 1/4 lines = 0.34' South and 1.55' West

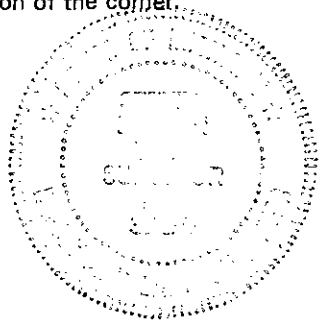


Signed by Steve Lampen Date DECEMBER 31, 1999
Surveyor's Michigan License No. 37279



PROPERTY &
SECTION

MAR 07 2000

SECTION

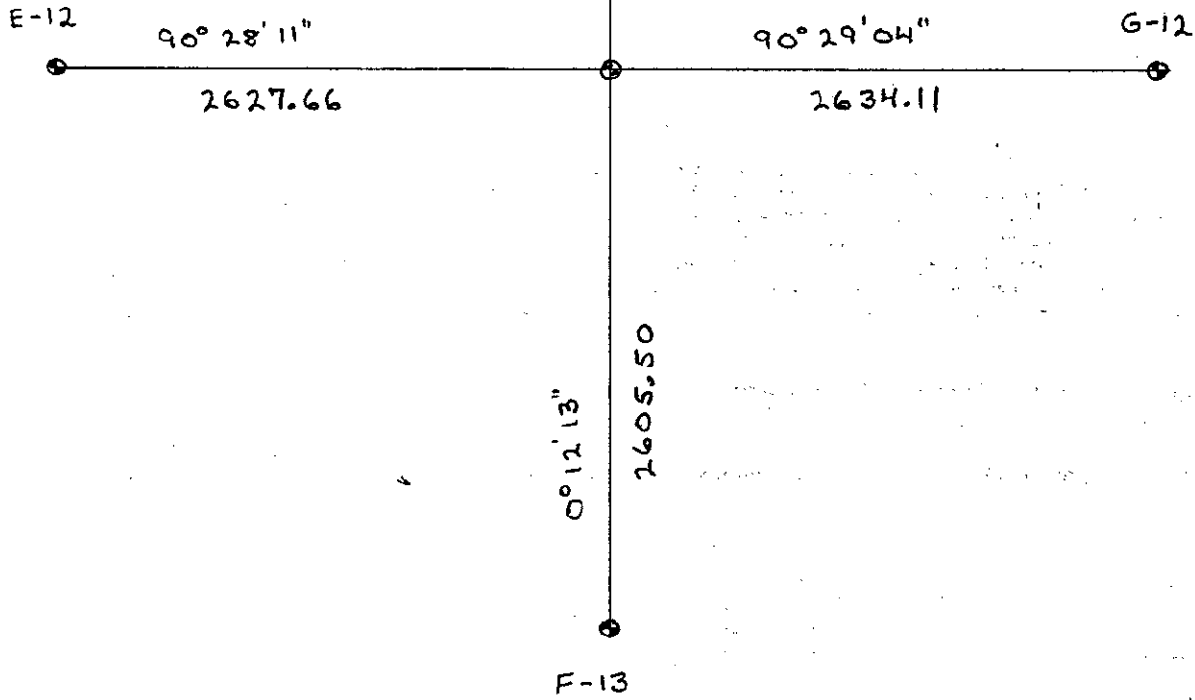

ENCLOSURE / PAGES 33

PROPERTY &
SECTION
MAR 07 2000
SECTION