

**SURVEY  
REMONUMENTATION**

APR 29 1999

**ALLEGAN COUNTY REMONUMENTATION  
LAND CORNER RECORDATION CERTIFICATE  
Filing Requirement of Act 74, Mich. P.A. 1970**

**SECTION**

For corners in

ALLEGAN Located In: Saugatuck Corner Code #  
(County)

1. Public Land Survey T 3N R 16W G-13  
T     R     SE SEC 33  
T     R          
T     R        

2. Property Controlling S     T     R      
in Section S     T     R      
3. Miscellaneous S     T     R      
Property in Sec. S     T     R    

FILED  
1/28/1999 2:44:39 PM  
JOYCE A. WATTS  
REGISTER OF DEEDS  
ALLEGAN COUNTY, MICH  
Register of Deeds Stamp & File Number

LIBERO 007 PABED 84

4. Lot No. \_\_\_\_\_, Recorded Plat \_\_\_\_\_  
5. Private Claims \_\_\_\_\_

I, Robert E. Lemke, in a field survey on September 14, 1998 do hereby state that under requirements of P.A. 74, Michigan P.A. of 1970, the corner points mentioned in lines 1 and 2 above were in conformance with regulations and rules therefore as required in the current manual of survey instructions of the United States Department of the Interior, Bureau of Land Management or by a decree of a Court of Law and/or that the corner points mentioned in lines 3, 4 and 5 above were in conformance with the rules of the Michigan Board of Land Surveyors or by a Decree of a Court of Law; established, reestablished, monumented, recovered, found as expressed below:

	A	B	C	D	E	F	G	H	I	J	K	L	M
1													
2	6			5			4			3			2
3													
4	7			8			9			10			11
5													
6	18			17			16			15			14
7													
8	19			20			21			22			23
9													
10	30			29			28			27			26
11													
12	31			32			33			34			35
13													

**NOTE: Not more than 2 corners, all in the same town and range, may be recorded on this certificate.**

A. Description of original monument and accessories and/or subsequent restoration:  
(see back of page)


B. Description of corner evidence found and/or method applied in restoring or reestablishing corner:  
Found 1" Iron in Monument box.  
Witness's per LCRC Liber 2, page 235  
(a) Measured = 67.67' (Recorded = 68.20)  
(b) Measured = 62.79' (Recorded = 62.75)  
(c) Measured = 73.92' (Recorded = 74.96)  
(d) Measured = 1.0' (Recorded = 1.0')  
Distance G1 to G13 Measured 10.55' (Record = 10.4' County Witness Card, Mitchel 1989 = 10.6')  
And is accepted as a careful and faithful **perpetuation** of the position of the original corner

C. Description of monument for corner and accessories established to perpetuate locating the position of the corner:

Replaced 1" Iron in Monument box with standard Allegan County monument ( 3/4" x 24" steel rod w/ red cap #23520)

Set standard Allegan Co. Remon tag & nail in the East side of a Power pole 2.3' above grade N 34 ° W 69.19'  
Set standard Allegan Co. Remon tag & nail in the Southeast side of a Power pole 2.2' above grade N 45 ° E 72.41'  
Set standard Allegan Co. Remon tag & nail in the Northeast side of a Power pole 1.5' above grade S 40 ° E 62.76'  
Set standard Allegan Co. Remon tag & nail in the North side of a Railroad tie fence post 1.5' above grade S 50 ° W 73.55'

G-13 to G-1 West 10.55'  
G-13 to H-13 2636.26'  
G-13 to F-13 2642.65'

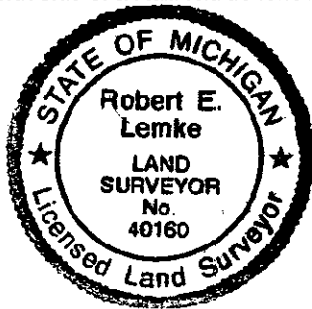

APPROVED REMONUMENTATION CORNER  
P.A.345 OF 1990  
ALLEGAN COUNTY  
DATE APPROVED NOV. 24, 1998

COUNTY REP. [Signature]

Signed by Robert E. Lemke  
License No. 40160 for SDI Consultants

Date 12/29/98 Nov 29, 1998 Surveyor's Michigan

SURVEY  
REMONUMENTATION

APR 20 1988

G-13

SAUGATUCK TWP.

SECTION

A. Description of original monument and accessories and/or subsequent restoration: G-13 continued:

GLO

Britain May 28, 1831

West South side sec 34

80.00 Ch.

set post cor. Secs 33&34

Hemlock 30 N 54 W 55lks

Beech 7 N 76 E 20lks

County Survey Notes

A. Gardner April 26, 1880

"Stone"

G13 to H13 40.01 Ch. (2640.66')

MDOT Right-of-way Map

Late 1920's

corner not shown

County Witness Card

unknown date

Section 3, T2N, R16 W

Shows NW corner of Sec. 3 as a "stone" 10.4' West of G-13 of section 34 Saugatuck

LCRC Liber 2, page 235

D.A. Ratekin Nov. 14, 1973

1" Iron in Mon Box

(a) SW cor Tele Outlet N50°W 68.20'

(b) Nail in P.Pole (NE side) S50°E 62.75'

(c) SE cor Tele Outlet N45°E 74.96'

(d) Centerline Rd North 1.0'

Holland Engineering Witness Card

same witness's as LCRC Liber 2, page 235

Mitchell Survey Witness Card

1979

same witness's as LCRC Liber 2, page 235

1989

same witness's as LCRC Liber 2, page 235

added Ganges Cor-West-10.6'

Survey

D.R. Ratekin June 06, 1973, and July 01, 1975

same witness's as LCRC Liber 2, page 235

LIBER 007 PAGE 85