

**SURVEY
REMONUMENTATION**

APR 29 1999

SECTION

**ALLEGAN COUNTY REMONUMENTATION
LAND CORNER RECORDATION CERTIFICATE
Filing Requirement of Act 74, Mich. P.A. 1970**

For corners in
Allegan
(County)

Located In: Corner Code #

1. Public Land Survey T3N R16W H-1
T R
T R North 1/4 ccr. Sec. 3
T R Saugatuck Twp.

2. Property Controlling S T R
in Section S T R

3. Miscellaneous S T R
Property in Sec. S T R

4. Lot No. _____, Recorded Plat _____

5. Private Claims _____

FILED
1/28/1999 2:44:39 PM

JOYCE A. WATTS
REGISTER OF DEEDS
ALLEGAN COUNTY, MICH

Register of Deeds Stamp & File Number

LIBERO 007 PABED 86

I, Steve Lampen, in a field survey on December 4, 1998, do hereby certify that under requirements of P.A. 74, Michigan P.A. of 1970, the corner points mentioned in lines 1 and 2 above were in conformance with regulations and rules therefore as required in the current manual of survey instructions of the United States Department of the Interior, Bureau of Land Management or by a decree of a Court of Law and/or that the corner points mentioned in lines 3, 4 and 5 above were in conformance with the rules of the Michigan Board of Land Surveyors or by a Decree of a Court of Law; established, re-established, monumented, re-monumented, recovered, found as expressed below:

NOTE: Not more than 4 corners, all in the same town and range, may be recorded on this certificate.

A. Description of original monument and accessories and/or subsequent restoration:
H-1 L.C.R.C. L4, P08 - Grear - 1987
GLO - corner Found 1" iron
Not set by GLO 20" Maple NW 25.92
20" Oak W 49.18
L.C.R.C. L1, P378 - Ratekin - 1972 20" Oak SSW 88.11
Found 1" iron Laketown corner W 10.23
20" Maple S 40° W 47.1
20" Oak W 48.8
16" Maple N 40° W 25.4
10" Cherry N 70° E 49.4

B. Description of corner evidence found and/or method applied in restoring or reestablishing corner:
H-1 Found 1" iron on the South line of Section 34, Town 4 North, Range 16 West
15" Maple W 48.8 16" Maple N 40° West 25.4 10" Cherry N 70° E 49.4
20" Oak SSW 88.11 14" Ash ESE 32.05 Laketown corner W 10.23

Replaced 1" iron with 3/4"x24" Allegan County Remonumentation iron and cap. This corner not monumented by the original GLO Survey. This position is accepted as the best available evidence of the position of the Corner.

Traversed 2657 ft. on road


This corner was approved by the Allegan County Remonumentation Peer Group on December 8, 1998.

APPROVED REMONUMENTATION CORNER
P.A. 345 OF 1990
ALLEGAN COUNTY
DATE APPROVED DEC. 8, 1998
COUNTY REP. *Steve Lampen*

C. Description of monument for corner and accessories established to perpetuate locating the position of the corner:
H-1 3/4"x24" Allegan County Remonumentation iron and cap on the South line of Section 34, Town 4 North, Range 16 West.

Azimuth = Michigan State Plane grid direction

24" Oak, remonumentation tag in E side	186° 53'	88.72
12" Ash, remonumentation tag in W side	15° 31'	18.53
NE corner house, block	234° 28'	88.46
30" Maple, remonumentation tag in NNW side	326° 20'	25.96
8" Maple, remonumentation tag in SSW side	128° 22'	43.76
H-13, Town 4 North, Range 16 West	270° 40'	10.27

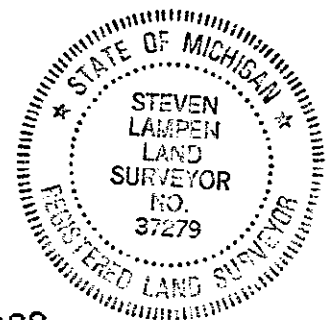

Signed by *Steven Lampen*

Date JANUARY 11, 1999

Surveyor's Michigan License No. 37279