

APR 29 1999

ALLEGAN COUNTY REMONUMENTATION
LAND CORNER RECORDATION CERTIFICATE
Filing Requirement of Act 74, Mich. P.A. 1970

SECTION

For corners in

<u>ALLEGAN</u> (County)	Located In: Saugatuck	Corner Code #
1. Public Land Survey	T <u>3N</u> R <u>16W</u>	<u>H-13</u>
	T <u> </u> R <u> </u>	<u>S 1/4 SEC 34</u>
	T <u> </u> R <u> </u>	<u> </u>
	T <u> </u> R <u> </u>	<u> </u>
2. Property Controlling in Section	S <u> </u> T <u> </u> R <u> </u>	<u> </u>
	S <u> </u> T <u> </u> R <u> </u>	<u> </u>
3. Miscellaneous Property in Sec.	S <u> </u> T <u> </u> R <u> </u>	<u> </u>
	S <u> </u> T <u> </u> R <u> </u>	<u> </u>

FILED

1/28/1999 2:44:39 PM

JOYCE A. WATTS
REGISTER OF DEEDS
ALLEGAN COUNTY, MICH

Register of Deeds Stamp & File
Number

LIBERO 007 PAGE 87

4. Lot No. _____, Recorded Plat _____

5. Private Claims _____

I, Robert E. Lemke, in a field survey on September 16, 1998 do hereby state that under requirements of P.A. 74, Michigan P.A. of 1970, the corner points mentioned in lines 1 and 2 above were in conformance with regulations and rules therefore as required in the current manual of survey instructions of the United States Department of the Interior, Bureau of Land Management or by a decree of a Court of Law and /or that the corner points mentioned in lines 3, 4 and 5 above were in conformance with the rules of the Michigan Board of Land Surveyors or by a Decree of a Court of Law; established, reestablished, monumented, recovered, found as expressed below:

	A	B	C	D	E	F	G	H	I	J	K	L	M
1													
2	6		5		4		3		2		1		
3													
4	7		8		9		10		11		12		
5													
6	18		17		16		15		14		13		
7													
8	19		20		21		22		23		24		
9													
10	30		29		28		27		26		25		
11													
12	31		32		33		34		35		36		
13													


NOTE: Not more than 2 corners, all in the same town and range, may be recorded on this certificate.

- A. Description of original monument and accessories and/or subsequent restoration:
(see back of page)
- B. Description of corner evidence found and/or method applied in restoring or reestablishing corner:
 Found 1/2" Iron
 Witness's per LCRC Liber 3, page 178
 Witness's per County Witness Card
 20" Oak NW 108.6' Measured 106.50'
 North Leg of Sign SE 78.0' Measured 80.10'
 Witness's per County Witness Card
 CL M-89 North 1.5' Measured 2.00'
 1" Iron in M.B. West 9.24' Measured 9.24'
 1/2" Pipe w/cap North 51.5' Measured 52.10'

H13 to I13 Measured 2637.43' (Shown per County Surveyor Notes as 40.02 CH.(2641.32') & per Wightman = 2637.12')
 G13 to H13 Measured 2636.26' (Shown on County Surveyor Notes as 40.01 CH.(2640.66')
 And is accepted as a careful and faithful perpetuation of the position of the original corner.

C. Description of monument for corner and accessories established to perpetuate locating the position of the corner:

- Replaced 1/2" Iron with standard Allegan County monument (3/4" x 24" steel rod w/ red cap #23520)
- Set standard Allegan Co. Remon tag & nail in the West side of a 3" Elm 1.5' above grade S 15 ° E 55.49'
 Set standard Allegan Co. Remon tag & nail in the West side of the Northerly most Billboard sign post 0.5 above grade S 55 ° E 79.94'
 Iron rod with cap (number illegible) N 5 ° E 52.12'
 Set standard Allegan Co. Remon tag & nail in the East side of a 24" Oak 1.0' above grade N 55 ° W 105.97'
- H-13 to H-1 West 9.24'
 H-13 to I-13 2637.43'
 H-13 to G-13 2636.26'

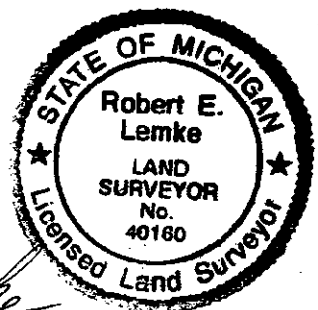

APPROVED REMONUMENTATION CORNER
 P.A.345 OF 1990
 ALLEGAN COUNTY
 DATE APPROVED Nov 24, 1998
 COUNTY REP. [Signature]

Signed by Robert E. Lemke Date 12/29/98 Surveyor's Michigan
 License No. 40160 for SDI Consultants

APR 29 1988

H-13 SAUGATUCK TWP.

SECTION

A. Description of original monument and accessories and/or subsequent restoration: H-13 continued:

GLO
Britain, 1831
West South side sec 34
40.00 Ch.
Lynn 30 for quarter sec. cor. tree

MDOT Right-of-way Map
Late 1920's
corner not shown

County Survey Records
A. Gardner April 26, 1880
"Stake"
G13 to H13 40.01 Ch.
H13 to I13 40.02 Ch.

LCRC Liber 3, page 178
G.J. Mitchell Dec. 22, 1977
Iron in Mon. Box
(a) 20" Oak NW 108.6'
(b) North Leg of Sign SE 78.0'
(c) 8" Pear NNE 71.0'

County Witness Card
Feb. 25, 1983
Set P.K.
CL M-89 North 1.5'
1" Iron in M.B. West 9.24'
1/2" Pipe w/cap North 51.5'

Wightman Moored field notes
Aug. 11, 1987
S 1/4 Post Sec. 34 Saug.
PK B. Top over
FD. Mon. West 9.24'
FD. R/W cap & Pipe North 50.00'
CL M-89 North 1.5'
H13 to I13 2637.12'

LIBERO 007 PAGE 88