

**SURVEY
REMONUMENTATION**

APR 29 1999

SECTION

**ALLEGAN COUNTY REMONUMENTATION
LAND CORNER RECORDATION CERTIFICATE
Filing Requirement of Act 74, Mich. P.A. 1970**

For corners in <u>Allegan</u> <small>(County)</small>	Located In:	Corner Code #
1. Public Land Survey	T3N R16W	I-1
	T _____ R _____	
	T _____ R _____	NE corner Section 3,
	T _____ R _____	Saugatuck Twp.
2. Property Controlling in Section	S _____ T _____ R _____	
	S _____ T _____ R _____	
3. Miscellaneous Property in Sec.	S _____ T _____ R _____	
	S _____ T _____ R _____	

FILED
1/28/1999 2:44:39 PM
JOYCE A. WATTS
REGISTER OF DEEDS
ALLEGAN COUNTY, MICH
Register of Deeds Stamp & File Number

LIBERO007 PAGE089

4. Lot No. _____, Recorded Plat _____
5. Private Claims _____

I, Steve Lampen, in a field survey on December 4, 1998, do hereby certify that under requirements of P.A. 74, Michigan P.A. of 1970, the corner points mentioned in lines 1 and 2 above were in conformance with regulations and rules therefore as required in the current manual of survey instructions of the United States Department of the Interior, Bureau of Land Management or by a decree of a Court of Law and/or that the corner points mentioned in lines 3, 4 and 5 above were in conformance with the rules of the Michigan Board of Land Surveyors or by a Decree of a Court of Law; established, re-established, monumented, re-monumented, recovered, found as expressed below:

1	A	B	C	D	E	F	G	H	I	J	K	L	M
2		6	5	4	3	2	1						
3													
4		7	8	9	10	11	12						
5													
6		18	17	16	15	14	13						
7													
8		19	20	21	22	23	24						
9													
10		30	29	28	27	26	25						
11													
12		31	32	33	34	35	36						
13													

NOTE: Not more than 4 corners, all in the same town and range, may be recorded on this certificate.

A. Description of original monument and accessories and/or subsequent restoration:
I-1 L.C.R.C. - L1, P378 - Ratekin - 1972
GLO-Britain-8 June 1831 Found 5/8" iron
N between Sec.'s 2 and 3 SE cor. store N 38° W 85.67
88.75 N boundary 7 W of post Power pole N 53° E 45.19
Set corner to Sections 2 & 3

Old County Notes
Concrete block bldg NW 85.6
4' W of SW cor. Sec. 35, T4N, R16W

MSH - 1960
1 1/2" pipe, 1 1/2' deep
N 38° W se cor. store 85.67
N 53° E Power pole 45.19
S 45° W Telephone pole 51.49

B. Description of corner evidence found and/or method applied in restoring or reestablishing corner:
I-1 Found 3/4" iron in monument box on the South line of Section 34, Town 4 North, Range 16 West
North 38° W SE corner store 85.67 Power pole N 53° E 85.67 4 ft. West of SW corner Section 35, T4N, R16W

Replace 3/4" iron with 3/4"x24" Allegan County Remonumentation iron and cap and accepted it as a careful and Faithful perpetuation of the position of the original corner.


Traversed 2657 ft. on road

The corner was approved by the Allegan County Remonumentation Peer Group on December 8, 1998.

APPROVED REMONUMENTATION CORNER
P.A. 345 OF 1990
ALLEGAN COUNTY
DATE APPROVED DEC 8, 1998
COUNTY REP. [Signature]

C. Description of monument for corner and accessories established to perpetuate locating the position of the corner:
I-1 3/4"x24" Allegan County Remonumentation iron and cap in monument box and on the South line of Section 34, Town 4 North, Range 16 W
Azimuth = Michigan State Plane grid direction

Power pole, remonumentation tag in NW side	49° 25'	45.18
Power pole, remonumentation tag in SW side	148° 50'	132.21
Telephone pole, remonumentation tag in NW side	223° 56'	51.36
Westerly corner building, metal siding	116° 36'	185.22
NE corner building, concrete block	336° 52'	153.41
SW corner building, concrete block	299° 54'	132.05
SE corner building, concrete block	320° 12'	85.68
I-13, Town 4 North, Range 16 West	90° 44'	4.00

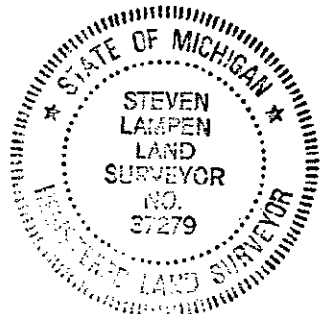

Signed by Steven Lampen Date JANUARY 11, 1999
Surveyor's Michigan License No. 37279