

**SURVEY  
REMONUMENTATION**

APR 29 1999

**SECTION**

**ALLEGAN COUNTY REMONUMENTATION  
LAND CORNER RECORDATION CERTIFICATE  
Filing Requirement of Act 74, Mich. P.A. 1970**

For corners in  
Allegan  
(County)

Located In: \_\_\_\_\_ Corner Code # \_\_\_\_\_

1. Public Land Survey T3N R16W J-1  
T R  
T R  
T R  
North 1/4 corner,  
Sec. 2, Saugatuck  
Twp.

2. Property Controlling S T R  
in Section S T R  
3. Miscellaneous S T R  
Property in Sec. S T R

4. Lot No. \_\_\_\_\_, Recorded Plat \_\_\_\_\_

5. Private Claims \_\_\_\_\_

FILED  
1/28/1999 2:44:39 PM  
JOYCE A. WATTS  
REGISTER OF DEEDS  
ALLEGAN COUNTY, MICH  
**Register of Deeds Stamp & File Number**

LIBR0007 PAGE092

I, Steve Lampen, in a field survey on December 4, 1998, do hereby certify that under requirements of P.A. 74, Michigan P.A. of 1970, the corner points mentioned in lines 1 and 2 above were in conformance with regulations and rules therefore as required in the current manual of survey instructions of the United States Department of the Interior, Bureau of Land Management or by a decree of a Court of Law and/or that the corner points mentioned in lines 3, 4 and 5 above were in conformance with the rules of the Michigan Board of Land Surveyors or by a Decree of a Court of Law; established, re-established, monumented, re-monumented, recovered, found as expressed below:

**NOTE: Not more than 4 corners, all in the same town and range, may be recorded on this certificate.**

**A. Description of original monument and accessories and/or subsequent restoration:**

J-1 MSH-1960  
GLO-corner Guy rod  
Not set by GLO N 32° W 8" Maple 65.9  
East 3.51 (Jog)  
Old County Notes - Stone

Survey - L799, P173 - Ratekin -1971  
Stone  
3.51' W of S 1/4 corner T4N, R16W

**B. Description of corner evidence found and/or method applied in restoring or reestablishing corner:**

J-1 Found 3/4" iron in monument box 0.04' North of South line Section 35, Town 4 North, Range 16 West  
North 32° W 8" Maple 66.62 East 3.51 (jog)

Replaced 3/4" iron with 3/4"x24" Allegan County Remonumentation iron and cap on the South line of Section 35, Town 4 North, Range 16 West.

This corner was not monumented by the original GLO Survey. This position is accepted as the best available Evidence of the position of the corner.

Traversed 2648 ft. on road

This corner was accepted by the Allegan County Remonumentation Peer Group on December 8, 1998.


**APPROVED REMONUMENTATION CORNER**  
P.A. 345 OF 1990  
ALLEGAN COUNTY  
DATE APPROVED DEC 8 1998  
COUNTY REP. [Signature]

**C. Description of monument for corner and accessories established to perpetuate locating the position of the corner:**

J-1 3/4"x24" Allegan County Remonumentation iron and cap in monument box on the South line of Section 35, Town 4 North, Range 16 West.

Azimuth = Michigan State Plane grid direction

|  |          |        |
|--|----------|--------|
| SW corner house foundation                 | 332° 46' | 167.00 |
| Power pole, remonumentation tag in E side  | 193° 54' | 127.20 |
| Guy pole, remonumentation tag in W side    | 169° 14' | 157.07 |
| Power pole, remonumentation tag in S side  | 79° 55'  | 193.18 |
| Power pole, remonumentation tag in SW side | 326° 18' | 43.43  |
| J-13, Town 4 North, Range 16 West          | 90° 55'  | 3.51   |

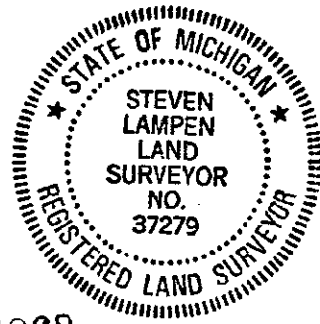

Signed by Steven Lampen Date JANUARY 11, 1999

Surveyor's Michigan License No. 37279