

**SURVEY  
REMONUMENTATION**

APR 29 1999

**SECTION**

**Allegan County Remonumentation  
LAND CORNER RECORDATION CERTIFICATE  
Filing Requirement of Act 74, Mich. P.A. 1970**

LIBR0007 PAGE 95

For corners in  
Allegan  
(County)

Located In: \_\_\_\_\_ Corner Code # \_\_\_\_\_

1. Public Land Survey T3N R16W K-1 (NW, Sec. 1)  
T R Saugatuck Twp.  
T R \_\_\_\_\_  
T R \_\_\_\_\_

2. Property Controlling S T R \_\_\_\_\_  
in Section S T R \_\_\_\_\_  
3. Miscellaneous S T R \_\_\_\_\_  
Property in Sec. S T R \_\_\_\_\_

4. Lot No. \_\_\_\_\_, Recorded Plat \_\_\_\_\_

5. Private Claims \_\_\_\_\_

FILED  
1/28/1999 2:44:39 PM  
JOYCE A. MATTS  
REGISTER OF DEEDS  
ALLEGAN COUNTY, MICH  
**Register of Deeds Stamp & File Number**

I, Steven Lampen, in a field survey on December 17, 1997, do hereby certify that under requirements of P.A. 74, Michigan P.A. of 1970, the corner points mentioned in lines 1 and 2 above were in conformance with regulations and rules therefore as required in the current manual of survey instructions of the United States Department of the Interior, Bureau of Land Management or by a decree of a Court of Law and/or that the corner points mentioned in lines 3, 4 and 5 above were in conformance with the rules of the Michigan Board of Land Surveyors or by a Decree of a Court of Law; established, re-established, monumented, re-monumented, recovered, found as expressed below:

**NOTE: Not more than 4 corners, all in the same town and range, may be recorded on this certificate.**

	A	B	C	D	E	F	G	H	I	J	K	L	M
1													
2	6	5	4	3	2	1							
3													
4	7	8	9	10	11	12							
5													
6	18	17	16	15	14	13							
7													
8	19	20	21	22	23	24							
9													
10	30	29	28	27	26	25							
11													
12	31	32	33	34	35	36							
13													

**A. Description of original monument and accessories and/or subsequent restoration:**

K-1  
GLO Britain 1832  
To North boundary 3 links E of post and Road Commission  
set corner Sec. 1 and 2 Iron in backslope road NNW 69.94'  
Beech 8" S 69 W 24 "X" in NW corner concrete headwall SSE 35.95'  
Beech 8" S 31 E 62 P.K. in 12" Maple SSE 55.24'  
P.K. in 7" Maple SSW 61.46'

Mitchell Survey  
1" iron 1988 County Notes  
T.C.B. SW 27.35' Stone  
W corner headwall S 16° W 37.22' 15" Maple NW 76.0'  
E corner headwall S 10° E 35.50' SW corner West headwall NW 17.5'  
SE corner E headwall NW 19.0'

**B. Description of corner evidence found and/or method applied in restoring or reestablishing corner:**

K-1  
Found 3/4" iron in monument box on S line Section 36, T4N, R16W

SW corner Section 36, T4N, R16W, W 1.98'

Replaced iron with 3/4"x24" Allegan County Remonumentation cap in an existing monument box and accepted it as a careful and faithful re-establishment of the original corner.


This corner was approved by the Allegan County Surveyors Peer Group on February 11, 1997.

APPROVED REMONUMENTATION CORNER  
P.A. 345 OF 1990  
ALLEGAN COUNTY  
DATE APPROVED FEB. 11, 1997  
COUNTY REP. *[Signature]*

**C. Description of monument for corner and accessories established to perpetuate locating the position of the corner:**

K-1  
Allegan County Remonumentation iron and cap in monument box.

Power pole Remon. tag E'ly side 345° 36' 155.04'  
12" Willow Remon. tag N'ly side 234° 15' 55.85'  
"X" in end of 24" concrete culvert 320° 52' 57.48'  
"X" in end of 24" concrete culvert 118° 14' 99.44'  
K-13, T4N, R16W, 271° 07' 1.98'  
SW corner house foundation, concrete block 69° 21' 188.80'

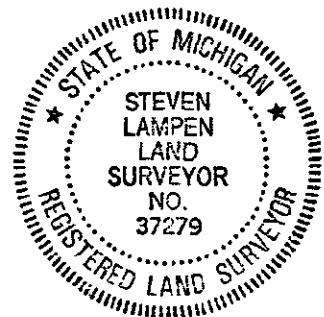

Signed by *Steven Lampen*

Date February 12, 1997

Surveyor's Michigan License No. 37279