

MAR 07 2000

SECTION

ALLEGAN COUNTY REMONUMENTATION
LAND CORNER RECORDATION CERTIFICATE
Filing Requirement of Act 74, Mich. P.A. 1970

REGISTER OF DEEDS
ALLEGAN COUNTY, MICH.
James A. Stone

00 FEB - 1 AM 8:51

LIBRARY / PAPER 33
FILED

For corners in
Allegan
(County)

Located In: Corner Code #

1. Public Land Survey T3N R16W M-11
T R
T R NE Corner
T R Section 36

2. Property Controlling S T R Saugatuck Twp.
in Section S T R

3. Miscellaneous S T R

Property in Sec. S T R

4. Lot No. _____, Recorded Plat _____

5. Private Claims _____

Register of Deeds Stamp & File Number

I, Steve Lampen, in a field survey on December 4, 1999, do hereby certify that under requirements of P.A. 74, Michigan P.A. of 1970, the corner points mentioned in lines 1 and 2 above were in conformance with regulations and rules therefore as required in the current manual of survey instructions of the United States Department of the Interior, Bureau of Land Management or by a decree of a Court of Law and/or that the corner points mentioned in lines 3, 4 and 5 above were in conformance with the rules of the Michigan Board of Land Surveyors or by a Decree of a Court of Law; established, re-established, monumented, re-monumented, recovered, found as expressed below:

NOTE: Not more than 4 corners, all in the same town and range, may be recorded on this certificate.

A. Description of original monument and accessories and/or subsequent restoration:

M-11 1977 - G. Mitchell
GLO - 1831 - L. Lyon - Set Post LCRC L-3, P-153
Hemlock 28 N46W 64 Found 1" Iron
Sugar 16 S54W 56 Street Sign SSW 20.81'
Tel Cable Box NE 48.65'
Tel Cable Box WNW 75.31'

1857 - Elisha Mix - Stone
10" Ash SW 26.5'
8" Apple SE 64'

1995 - R. Vugteveen
Recorded Survey L-1511, P-107
3/4" Solid Iron
PK Nail NE Side P Pole N25W 110.79'
PK Nail NE Side P Pole S60E 128.94'
PK Nail E Side P Pole S15W 74.09'
Iron in Mon Box 8.63' South

Consumers Power Co. - 1960's
SW Corner Section 30-3-15 S 8.58'

B. Description of corner evidence found and/or method applied in restoring or reestablishing corner:

M-11 Found 3/4" Iron in Monument Box.
PK Nail NE Side P Pole N25W 110.79'
PK Nail NE Side P Pole S60E 128.94'
PK Nail E Side P Pole S15W 74.09'

A-11, T3N, R15W S 8.58'
Pulled iron and set standard Allegan County
3/4" x 24" iron with red cap #23520 in Mon Box.


Approved by the Allegan County Remon Peer Group
On December 14, 1999 and is accepted as a careful
and faithful perpetuation of the position of the
original corner.

APPROVED REMONUMENTATION CORNER
P.A. 345 OF 1990
ALLEGAN COUNTY
DATE APPROVED DEC. 14, 1999.
COUNTY REP. *[Signature]*

C. Description of monument for corner and accessories established to perpetuate locating the position of the corner:

M-11 Standard Allegan County Remonumentation 3/4" x 24" iron with red cap #23520 in Monument Box.
Azimuth = Michigan State Plane grid direction.

Remonumentation tag in E side Power Pole 193° 29' 74.11'
Remonumentation tag in N side Power Pole 122° 39' 129.06'
Remonumentation tag in S side Power Pole 74° 26' 113.19'
Remonumentation tag in E side Power Pole 334° 44' 110.83'
NW Corner House, Stone 119° 47' 210.67'
CL East and West Asphalt Road Pavement 180° 00' 3'
A-11, T3N, R15W 180° 14' 8.58'

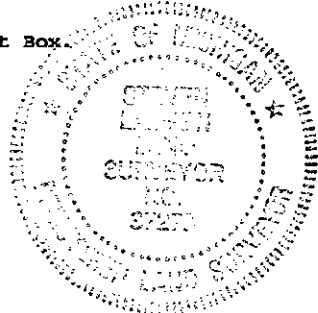

Signed by Steven Lampen Date DECEMBER 31, 1999

Surveyor's Michigan License No. 37279