

APR 29 1999

SECTION

ALLEGAN COUNTY REMONUMENTATION
LAND CORNER RECORDATION CERTIFICATE
Filing Requirement of Act 74, Mich. P.A. 1970

For corners in

Allegan

(County)

Located In:

Leighton Twp.

Corner Code #

1. Public Land Survey

T 4NR 11W

A-4

T R

T R

T R

2. Property Controlling
in Section

S

T R

S

T R

3. Miscellaneous
Property in Sec.

S

T R

S

T R

4. Lot No. _____, Recorded Plat _____

5. Private Claims _____

I, Robert Jonker, in a field survey on 10-22, 1998 do hereby state that under requirements of P.A. 74, Michigan P.A. of 1970, the corner points mentioned in lines 1 and 2 above were in conformance with regulations and rules therefore as required in the current manual of survey instructions of the United States Department of the Interior, Bureau of Land Management or by a decree of a Court of Law and/or that the corner points mentioned in lines 3, 4 and 5 above were in conformance with the rules of the Michigan Board of Land Surveyors or by a Decree of a Court of Law; established, re-established, monumented, recovered, found as expressed below:

NOTE: Not more than 2 corners, all in the same town and range, may be recorded on this certificate.

A. Description of original monument and accessories and/or subsequent restoration:

not set in G.L.O. survey

(see additional info over)

B. Description of corner evidence found and/or method applied in restoring or reestablishing corner:

Found 3/4" iron in mon box #7
wit. listed in "A" above corner

This position not established by original government surveyors. This monument is accepted as the best available evidence of the position of the corner.

C. Description of monument for corner and accessories established to perpetuate locating the position of the corner:

Replaced with std. Allegan co. Monument to twp. line
Set nail & tag in S. side p. pole N60°W 28.52'
Found nail in SW Side 34" oak N26°W 54.19'
Found PK nail in E. Side p. pole S20°W 105.15'
Found nail in N. side basswood clump N85°E 44.26'
NE cor gar. S80°W 91.95'
Allegan co. remon pin in mon box N. 9.20'

FILED

1/28/1999 2:44:39 PM

JOYCE A. WATTS
REGISTER OF DEEDS
ALLEGAN COUNTY, MICH

Register of Deeds Stamp & File Number


	A	B	C	D	E	F	G	H	I	J	K	L	M
1													
2	6		5		4		3		2		1		
3													
4	7		8		9		10		11		12		
5													
6	18		17		16		15		14		13		
7													
8	19		20		21		22		23		24		
9													
10	30		29		28		27		26		25		
11													
12	31		32		33		34		35		36		
13													

LIBER0006 PAGE 76

Signed by Robert J. Jonker

Date 11-9-98

Surveyor's Michigan License No. 21572

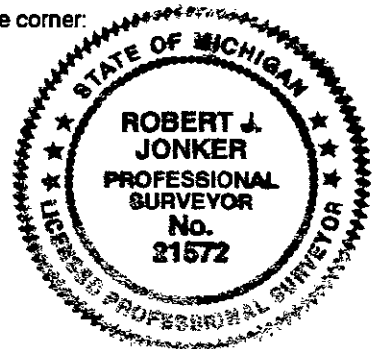

A-4 LEIGHTON TWP

1. old Witness sheet - no date - iron 10-22-98
guy pole WNW 19.5' out
24" oak NW 52.8' check ok
T. pole ENE 23.2' out
2. Ratekin - LCRC - 1971 - 1 1/2" pipe L. 1, P. 102
guy pole WNW 26.95' out
24" oak NW 52.8' check ok
T. pole ENE 23.2' out
NE. Cor. garage S80°W 91.75" check ok
3. Holland eng. - no date
3/4" solid iron in nom box
Nail in E. Root 30" oak NW 52.33' check ok
PK nail Side p.pole S20°W 104.82' check ok
Nail N Side ch. slump. N85°E 44.27' check ok
Iron in mon box N 9.24' check ok
(East 1/4 sec. 12, Dorr Twp.)

SURVEY
REMONUMENTATION

APR 29 1999

SECTION

LIBERO 006 PAGE 77