

RECORDED
MAR 07 2000

SECTION

ALLEGAN COUNTY REMONUMENTATION
LAND CORNER RECORDATION CERTIFICATE
Filing Requirement of Act 74, Mich. P.A. 1970

LIBR0007 PAGE360
FILED
00 FEB -1 AM 8:42
REGISTER OF DEEDS
ALLEGAN COUNTY MICH
Hager & ...

For corners in
Allegan
(County)

Located In: Leighton Twp. Corner Code #

1. Public Land Survey	T 4N R 11W	A-10
	T R	
	T R	
	T R	
2. Property Controlling in Section	S T R	
	S T R	
3. Miscellaneous Property in Sec.	S T R	
	S T R	

Register of Deeds Stamp & File Number

4. Lot No. _____, Recorded Plat _____
5. Private Claims _____

I, Robert J Jonker, in a field survey on 12-10, 1999 do hereby state that under requirements of P.A. 74, Michigan P.A. of 1970, the corner points mentioned in lines 1 and 2 above were in conformance with regulations and rules therefore as required in the current manual of survey instructions of the United States Department of the Interior, Bureau of Land Management or by a decree of a Court of Law and for that the corner points mentioned in lines 3, 4 and 5 above were in conformance with the rules of the Michigan Board of Land Surveyors or by a Decree of a Court of Law; established, re-established, monumented, recovered, found as expressed below:

A	B	C	D	E	F	G	H	I	J	K	L	M
1												
2	6	5	4	3	2	1						
3												
4	7	8	9	10	11	12						
5												
6	18	17	16	15	14	13						
7												
8	19	20	21	22	23	24						
9												
10	30	29	28	27	26	25						
11												
12	31	32	33	34	35	36						
13												

NOTE: Not more than 2 corners, all in the same town and range, may be recorded on this certificate.

A. Description of original monument and accessories and/or subsequent restoration:
Not set in GLO survey

APPROVED REMONUMENTATION CORNER
P.A. 345 OF 1990
ALLEGAN COUNTY
DATE APPROVED DEC. 14, 1999
COUNTY REP. [Signature]

over


B. Description of corner evidence found and/or method applied in restoring or reestablishing corner:
Fd. R.R. spike by wit. listed on "A" (over) (0.05 West of Twp line) removed & replaced with 36" Allegan co. Remon pin & cap on twp. line

This position not established by original government surveyors. This monument is accepted as the best available evidence of the position of the corner.

Peer group approved 12-14-99

C. Description of monument for corner and accessories established to perpetuate locating the position of the corner:

3/4" X 36" std. Allegan Co. Monument on Twp line
PK nail - s. side p. pole N75°E 39.02'
PK nail - W. side p. pole S30°E 82.60'
PK nail - N. side p. pole N60°W 24.25'
sq. bolt. North 13.28' - Dorr Twp. Cor.
C/L N-S road as traveled 6' +/- East

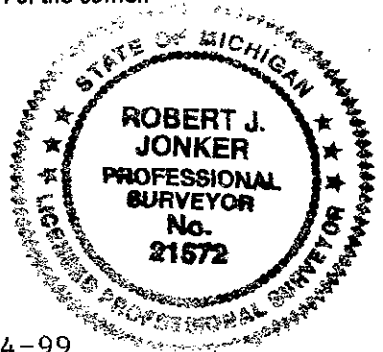

Signed by Robert J. Jonker
Surveyor's Michigan License No. 21572

Date 12-14-99

