

RECORDED

MAR 07 2000

Allegan County Remonumentation
LAND CORNER RECORDATION CERTIFICATE
Filing Requirement of Act 74, Mich. P.A. 1970

REGISTER OF DEEDS
ALLEGAN COUNTY, MICH.
Joyce A. Kertin

00 FEB -1 AM 8:42

FILED
MEMO 007 PAGE 62

SECTION

For corners in

| Allegan (County) | Located In: Leighton Twp. | Corner Code # |
|---------------------------------------|------------------------------|---------------|
| 1. Public Land Survey | T 4N R 11W | A-11 |
| | T R | |
| | T R | |
| | T R | |
| 2. Property Controlling in Section | S T R | |
| | S T R | |
| 3. Miscellaneous Property in Sec. | S T R | |
| | S T R | |

Register of Deeds Stamp & File Number

4. Lot No. _____, Recorded Plat _____
5. Private Claims _____

I, Robert J Jonker, in a field survey on 12-10, 1999 do hereby state that under requirements of P.A. 74, Michigan P.A. of 1970, the corner points mentioned in lines 1 and 2 above were in conformance with regulations and rules therefore as required in the current manual of survey instructions of the United States Department of the Interior, Bureau of Land Management or by a decree of a Court of Law and/or that the corner points mentioned in lines 3, 4 and 5 above were in conformance with the rules of the Michigan Board of Land Surveyors or by a Decree of a Court of Law; established, re-established, monumented, recovered, found as expressed below:

NOTE: Not more than 2 corners, all in the same town and range, may be recorded on this certificate.

| | | | | | | | | | | | | | |
|----|---|----|---|----|---|----|---|----|---|----|---|----|---|
| | A | B | C | D | E | F | G | H | I | J | K | L | M |
| 1 | | | | | | | | | | | | | |
| 2 | | 6 | | 5 | | 4 | | 3 | | 2 | | 1 | |
| 3 | | | | | | | | | | | | | |
| 4 | | 7 | | 8 | | 9 | | 10 | | 11 | | 12 | |
| 5 | | | | | | | | | | | | | |
| 6 | | 18 | | 17 | | 16 | | 15 | | 14 | | 13 | |
| 7 | | | | | | | | | | | | | |
| 8 | | 19 | | 20 | | 21 | | 22 | | 23 | | 24 | |
| 9 | | | | | | | | | | | | | |
| 10 | | 30 | | 29 | | 28 | | 27 | | 26 | | 25 | |
| 11 | | | | | | | | | | | | | |
| 12 | | 31 | | 32 | | 33 | | 34 | | 35 | | 36 | |
| 13 | | | | | | | | | | | | | |

A. Description of original monument and accessories and/or subsequent restoration:
GLO - West boundary between Sections 30 and 31
76.28 ch. Intersect W. boundary 40 links
South of post & set post Sections 30 and 31
Beech 8 N45E 10
Sugar 8 S50E 20 (pages 135 and 136)

APPROVED REMONUMENTATION CORNER
P.A. 345 OF 1990
ALLEGAN COUNTY
DATE APPROVED DEC. 14, 1999
COUNTY REP. [Signature]


over
B. Description of corner evidence found and/or method applied in restoring or reestablishing corner:
Fd. 1" iron by wit. listed in "A" (over)
removed & replaced with 36" Allegan Co. pin & cap on twp. line
iron was 0.05' East of Twp line

And is accepted as a careful and faithful perpetuation of the position of the original corner.

Peer group approved 12-14-99

C. Description of monument for corner and accessories established to perpetuate locating the position of the corner:

3/4" X 36" Std. Allegan co. Mon.
Stop sign (N. edge post) S80°W 40.42'
Set nail & tag in SE side
P. pole S50°W 44.48'
PK in Guy pole S40°E 46.45'
Rd. nail & tag in SW side 18" hickory S65°E 77.75'
Allegan Co. Monument, North 26.55'

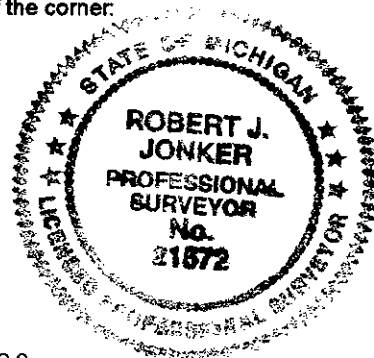

Signed by Robert J. Jonker
Surveyor's Michigan License No. 21572

Date 12-13-99

Part "A" cont.

Jonker - 1999

- 1. LCRC # 2-143, Ratekin, 1973
- Part A - card 1" iron & stake
- 40" Elm SE 30.9
- P. pole SW 33.9'
- G. pole SE 30.9'
- 16" Hick E. SE 75.2'

Out
 Moved
 Moved

Part B - Fd. "T" iron

- Part C - "T" iron
- st. sign S40°W 31.6'
- p. pole S45°W 43.8'
- G. pole S45°E 46.05'
- 16" Hickory S75°E 77.4'
- 1" iron N. 26.4' (NE Cor.
 Sec. 36, Dorr Twp.)

Out
 Check OK
 Check OK
 Check OK
 North 26.55'

- 2. Recorded survey, Ratekin, 1975
 same wit. as LCRC #2-143
- 3. Recorded survey, Jonker, Liber 1061, p. 280
 Same wit. as #2 above

RECEIVED
 SECTION

MAR 07 2000

SECTION

LIBERO 007 PAGES 63