

MAR 07 2000

Allegan County Remonumentation  
LAND CORNER RECORDATION CERTIFICATE  
Filing Requirement of Act 74, Mich. P.A. 1970

SECTION

For corners in

Allegan (County)	Located In: Leighton Twp.	Corner Code # A-12
1. Public Land Survey	T 4N R 11W	
	T R	
	T R	
	T R	
2. Property Controlling in Section	S T R	
	S T R	
3. Miscellaneous Property in Sec.	S T R	
	S T R	

REGISTER OF DEEDS  
ALLEGAN COUNTY, MICH.  
*James A. ...*

00 FEB -1 AM 8:42

FILED  
LIBRARY / PAGE 364

Register of Deeds Stamp & File Number

4. Lot No. \_\_\_\_\_, Recorded Plat \_\_\_\_\_  
5. Private Claims \_\_\_\_\_

I, Robert J Jonker, in a field survey on 10-12, 1999 do hereby state that under requirements of P.A. 74, Michigan P.A. of 1970, the corner points mentioned in lines 1 and 2 above were in conformance with regulations and rules therefore as required in the current manual of survey instructions of the United States Department of the Interior, Bureau of Land Management or by a decree of a Court of Law and/or that the corner points mentioned in lines 3, 4 and 5 above were in conformance with the rules of the Michigan Board of Land Surveyors or by a Decree of a Court of Law; established, re-established, monumented, recovered, found as expressed below:

NOTE: Not more than 2 corners, all in the same town and range, may be recorded on this certificate.

	A	B	C	D	E	F	G	H	I	J	K	L	M
1													
2		6		5		4		3		2		1	
3													
4		7		8		9		10		11		12	
5													
6		18		17		16		15		14		13	
7													
8		19		20		21		22		23		24	
9													
10		30		29		28		27		26		25	
11													
12		31		32		33		34		35		36	
13													

A. Description of original monument and accessories and/or subsequent restoration:  
Not set in GLO survey

APPROVED REMONUMENTATION CORNER  
P.A. 345 OF 1990  
ALLEGAN COUNTY  
DATE APPROVED DEC. 14, 1999  
COUNTY REP. *[Signature]*

over

B. Description of corner evidence found and/or method applied in restoring or reestablishing corner:  
Found 1" iron on twp. line - by wit. listed in "A" over  
Replaced with std. Allegan Co. Monument

This position not established by original government surveyors.  
This monument is accepted as the best available evidence of the position of the corner.

Peer group approved 12-14-99


C. Description of monument for corner and accessories established to perpetuate locating the position of the corner:

3/4" X 36" std. capped Allegan Co. Monument  
Allegan Co. Remon tag on N-ly side 24" Basswood S25°E 62.72'  
Allegan Co. Remon tag on S side 6" Basswood N71°W 63.25'  
Allegan Co. Remon tag on NE side 6" Basswood N29°W 53.18'  
East 1/4 Corner Section 36, Dorr, N. 5.95' - Co. Monument - on C/L  
Brush row to West

on C/L N-S gravel Road

Signed by Robert J. Jonker  
Surveyor's Michigan License No. 21572

Date 10-12-99

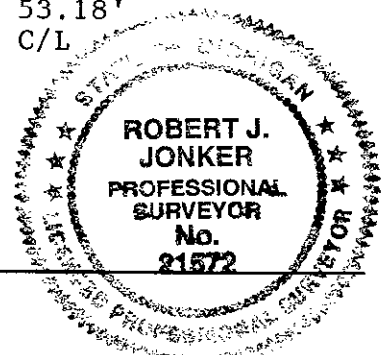

A-12 Part "A" Cont.

Jonker, 1999

LCRC #2-143, Ratekin - 1973

Part A - Card - 1" iron

6" popular S20°W 69.6'

Out

1" popular S55°W 35.0'

Out

E $\frac{1}{4}$  post Sec. 36, Dorr-N. 5.83'

Check OK

Part "B" Found 1" Iron

Part "C" 1" iron

6" popular S20°W 69.6'

Out

1" popular S55°W 35.0'

Out

C/L S. and 24" CMP N75°W 34.35'

Check OK

C/L N. and 24" C,P N45°W 46.0'

Check OK

1" iron N. 5.83' (E $\frac{1}{4}$  post Sec.36, Dorr)

Check OK

REVEY &  
SURVEYORS

MAR 07 2000

SECTION

LIBR000 / VAE365