

ALLEGAN COUNTY REMONUMENTATION  
 LAND CORNER RECORDATION CERTIFICATE  
 Filing Requirement of Act 74, Mich. P.A. 1970

For corners in

Allegan

(County)

Located In:

Leighton Twp.

Corner Code #

1. Public Land Survey	T <u>4N</u> R <u>11W</u>	<u>✓</u> J-13
	T <u>   </u> R <u>   </u>	_____
	T <u>   </u> R <u>   </u>	_____
	T <u>   </u> R <u>   </u>	_____
2. Property Controlling in Section	S <u>   </u> T <u>   </u> R <u>   </u>	_____
	S <u>   </u> T <u>   </u> R <u>   </u>	_____
3. Miscellaneous Property in Sec.	S <u>   </u> T <u>   </u> R <u>   </u>	_____
	S <u>   </u> T <u>   </u> R <u>   </u>	_____

*Robert J. Jonker*  
 REGISTER OF DEEDS  
 ALLEGAN COUNTY, MICH.

98 JAN 21 PM 1:26

FILED

Register of Deeds Stamp & File Number

4. Lot No. \_\_\_\_\_, Recorded Plat \_\_\_\_\_  
 5. Private Claims \_\_\_\_\_

I, Robert Jonker, in a field survey on 01-08, 1997 do hereby state that under requirements of P.A. 74, Michigan P.A. of 1970, the corner points mentioned in lines 1 and 2 above were in conformance with regulations and rules therefore as required in the current manual of survey instructions of the United States Department of the Interior, Bureau of Land Management or by a decree of a Court of Law and/or that the corner points mentioned in lines 3, 4 and 5 above were in conformance with the rules of the Michigan Board of Land Surveyors or by a Decree of a Court of Law; established, re-established, monumented, recovered, found as expressed below:

NOTE: Not more than 2 corners, all in the same town and range, may be recorded on this certificate.

1	A	B	C	D	E	F	G	H	I	J	K	L	M
2		6		5		4		3		2		1	
3													
4		7		8		9		10		11		12	
5													
6		10		17		16		15		14		13	
7													
8		19		20		21		22		23		24	
9													
10		30		29		28		27		26		25	
11													
12		31		32		33		34		35		36	
13													

A. Description of original monument and accessories and/or subsequent restoration:

1831 Sylvester Sibley D.S.  
 West on South side of Sec.35  
 40.00 ch., set post  
 W. Ash N49E 4  
 Birch 22 N71½W 71

G.L.O. jog of 65 links

APPROVED REMONUMENTATION CORNER  
 P.A. 345 OF 1990  
 ALLEGAN COUNTY  
 DATE APPROVED 4-8-97  
 COUNTY REP. K.V.O.

B. Description of corner evidence found and/or method applied in restoring or reestablishing corner:


1986 Jonker Land Survey looked for corners - found nothing.  
 Set at 65 links East (42.90') of Wayland corner per LCRC #1-399 and used J-1, Wayland and I-13, Leighton for alignment and extended East and set J-13. Falls on E-W tree and fence line, set capped rerod.

Accepted as a careful and faithful reestablishment of the position of the original corner.

Peer group approved Apr. 8, 1997.

C. Description of monument for corner and accessories established to perpetuate locating the position of the corner:

Replace with std. Allegan County monument  
 J-1, T3N, R11W, West 34.43'  
 Allegan Co. Remon Tag W. side 10" Ash S 14° E 36.70'  
 Allegan Co. Remon Tag NW side 20" Birch S 37° W 13.66'  
 Allegan Co. Remon Tag NW side 10" Ash S 63° W 23.66'  
 Allegan Co. Remon Tag E. side 8" Cherry N 25° W 9.52'

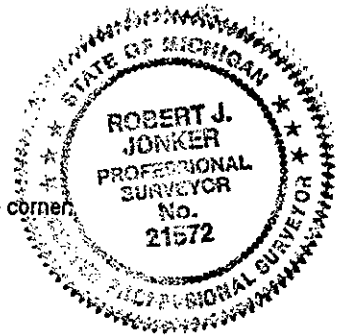

Signed by *Robert J. Jonker*  
 Surveyor's Michigan License No. 21572

Date 12-15-97