

Allegan County Remonumentation

LAND CORNER RECORDATION CERTIFICATE
Filing Requirement of Act 74, Mich. P.A. 1970

For corners in

Allegan (County)	Located In:	Corner Code #
	4N 11W	M-7 (SE, 13)
1. Public Land Survey	T _____ R _____	Leighton Twp.
	T _____ R _____	_____
	T _____ R _____	_____
	T _____ R _____	_____
2. Property Controlling in Section	S _____ T _____ R _____	_____
	S _____ T _____ R _____	_____
3. Miscellaneous Property in Sec.	S _____ T _____ R _____	_____
	S _____ T _____ R _____	_____


Steven C. Koerber
REGISTERED PROFESSIONAL SURVEYOR
ALLEGAN COUNTY, MICH.

1995 DEC 14 PM 2:34

FILED

Register of Deeds Stamp & File Number

4. Lot No. _____, Recorded Plat _____
5. Private Claims _____

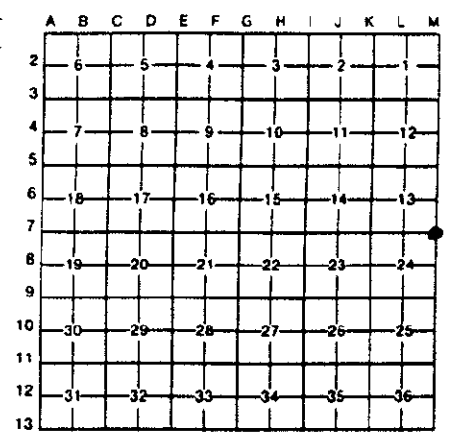

I, Steven Koerber, in a field survey on August 31, 19 95, do hereby certify that under requirements of P.A. 74, Michigan P.A. of 1970, the corner points mentioned in lines 1 and 2 above were in conformance with regulations and rules therefore as required in the current manual of survey instructions of the United States Department of the Interior, Bureau of Land Management or by a decree of a Court of Law and/or that the corner points mentioned in lines 3, 4 and 5 above were in conformance with the rules of the Michigan Board of Land Surveyors or by a Decree of a Court of Law; established, re-established, monumented, re-monumented, recovered, found as expressed below:

NOTE: Not more than 4 corners, all in the same town and range, may be recorded on this certificate.

A. Description of original monument and accessories and/or subsequent restoration:

M-7 GLO Lucius Lyon DS. 1826 Exxel Eng notes
W. Oak 40 S 6 W 47 Prev. measure 5.30 between found corners M-7 & A-7
Lynn 24 N 44 W 38

B. Description of corner evidence found and/or method applied in restoring or reestablishing corner:

M-7 Found 5/8" Solid iron rod
Found 5/8" iron rod North 5.30' GLO = 8 links = 5.28'
Found Nail & Tag in N. side P. pole N 65° E 92.00'
Found PK nail c/l top wood post N 40° E 53.19'


This corner is accepted as a careful and faithful perpetuation of the position of the original corner
Peer Group approval August 14, 1995

APPROVED REMONUMENTATION CORNER
P.A. 345 OF 1990
ALLEGAN COUNTY
DATE APPROVED 8-14-95
COUNTY REP. *[Signature]*

C. Description of monument for corner and accessories established to perpetuate locating the position of the corner:

M-7 Replaced 5/8" solid rod with Allegan Co. Mon. (3/4" x 24" Iron Rod with cap)
Set nail & Allegan Co. Remon. Tag in NW side wood fence post N 35° E 62.29'
Set nail & Allegan Co. Remon. Tag in SW side 16" Walnut S 45° E 71.18'
Set PK nail & Allegan Co. Remon. Tag in SW side P. Pole N 35° W 48.62'
PK nail c/l top wood post N 40° E 53.19'
Nail & Tag in N. side P. pole N 65° E 92.00'
C/L Stop/Street sign post N 65° E 43.5'
A-7 Thornapple Twp., Barry Co., corner is 5.30' North

Signed by *Steven C. Koerber* Date 11-13-1995
Surveyor's Michigan License No. 39085

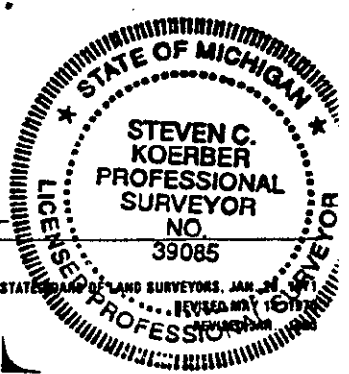

FORM APPROVED BY MICHIGAN STATE BOARD OF LAND SURVEYORS, JAN. 28, 1978
REVISED MAY 16, 1978