

**SURVEY  
REMONUMENTATION**

APR 29 1999

Allegan County Remonumentation

**LAND CORNER RECORDATION CERTIFICATE**  
Filing Requirement of Act 74, Mich. P.A. 1970

**SECTION**

For corners in

Allegan (County)	Located In:	Corner Code #
	4N 11W	M-11 (NE, Sec. 36)
1. Public Land Survey	T___ R___	Leighton Twp.
	T___ R___	_____
	T___ R___	_____
	T___ R___	_____
2. Property Controlling in Section	S___ T___ R___	_____
	S___ T___ R___	_____
3. Miscellaneous Property in Sec.	S___ T___ R___	_____
	S___ T___ R___	_____

FILED

1/28/1999 2:44:39 PM

JOYDE A. WATTS  
REGISTER OF DEEDS  
ALLEGAN COUNTY, MICH

LIBRO 006 PAGE 79

Register of Deeds Stamp & File Number

4. Lot No. \_\_\_\_\_, Recorded Plat \_\_\_\_\_  
5. Private Claims \_\_\_\_\_

Steven Koerber  
May 9 98

I, \_\_\_\_\_, in a field survey on \_\_\_\_\_, 19\_\_\_\_ do hereby state that under requirements of P.A. 74, Michigan P.A. of 1970, the corner points mentioned in lines 1 and 2 above were in conformance with regulations and rules therefore as required in the current manual of survey instructions of the United States Department of the Interior, Bureau of Land Management or by a Decree of a Court of Law and /or that the corner points mentioned in lines 3, 4 and 5 above were in conformance with the rules of the Michigan Board of Land Surveyors or by a Decree of a Court of Law; established, re-established, monumented, recovered, found as expressed below:

NOTE: Not more than 2 corners, all in the same town and range, may be recorded on this certificate.

	A	B	C	D	E	F	G	H	I	J	K	L	M
1													
2	6		5		4		3		2		1		
3													
4	7		8		9		10		11		12		
5													
6	18		17		16		15		14		13		
7													
8	19		20		21		22		23		24		
9													
10	30		29		28		27		26		25		
11													
12	31		32		33		34		35		36		
13													

A. Description of original monument and accessories and/or subsequent restoration:  
M-11 GLO Set Post, Lucius Lyons DS, 1826  
W. Oak 6 S41W 78  
R. Oak 13 N29W 93  
(Additional info. on back of sheet)


I. L.C.R.C. Liber 4, Pg. 143 Douglas Bonnema (Sept. 18, 1991)  
Set spk in S. sde. 20" Hickory N55°W 34.78'  
Set spk in N. sde 16" Hickory West 19.22'  
Set spk in SE sde P. Pole N40°E 67.52'  
Set spk in N. sde 22" Hickory N40°W 29.08'  
Set spk in NE sde 18" Hickory N40°W 56.79'  
1/2" iron at SW corner Section 30-4-10 North 10.60'

B. Description of corner evidence found and/or method applied in restoring or reestablishing corner:  
M-11 Found 1/2" Iron rod in Mon. Box  
Found PK nail Power Pole N20°E 67.77'  
Found nail in N. side 8" Twin Mulberry S75°E 67.79'  
Found PK nail in fnc. post N35°E 101.75'  
1/2" iron in Mon. box North 10.60' (NW cor Sec 31-4-10)  
Measure to M-10 2644.99'  
Measure to M-12 2653.40'

APPROVED REMONUMENTATION CORNER  
P.A. 345 OF 1990  
ALLEGAN COUNTY  
DATE APPROVED MAY 12, 1998  
COUNTY REP. *[Signature]*

And is accepted as a careful and faithful perpetuation of the position of the original corner.  
Peer Group approval May 12, 1998

C. Description of monument for corner and accessories established to perpetuate locating the position of the corner:  
M-11 Replaced 1/2" Iron rod with Allegan Co. Mon. (3/4" x 24" Iron Rod with cap)  
Set nail & Allegan Co. Remon. Tag in SE side P. Pole N40°E 67.80'  
Set nail & Allegan Co. Remon. Tag in N. side 22" Hickory N80°E 47.10'  
Set nail & Allegan Co. Remon. Tag in E. side P. Pole S15°E 137.95'  
Set nail & Allegan Co. Remon. Tag in S. side P. Pole N80°W 155.40'  
1/2" iron in Mon. box North 10.60' (NW cor Sec 31-4-10)  
In centerline Patterson Road

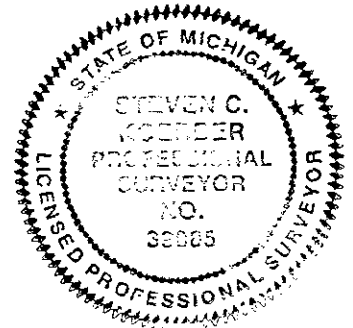

Signed by *[Signature]*  
Surveyor's Michigan License No. 39085

Date 6-11-1998

LEIGHTON TWP.

2. Act 132 recorded survey  
Sept. 13, 1991 Douglas Bonnema  
same wits as No. 1 above

3. L.C.R.C. Liber 4, Pg. 189 Basil Andress (Oct 1, 1992)  
1/2" iron  
Power Pole N20°E 67.77'  
24" Twin Cherry West 102.00'  
8" Twin Mulberry ESE 67.97'  
PK nail in fnc. post NE 101.90'  
1/2" iron North 10.60' (NW cor Sec 31-4-10)

SURVEY  
REMONUMENTATION

APR 29 1999

SECTION

LIBER 006 PAGE 80