

RF  
MAR 07 2000

FILED

Allegan County Remonumentation

LAND CORNER RECORDATION CERTIFICATE 00 FEB -1 AM 8:38  
Filing Requirement of Act 74, Mich. P.A. 1970

For corners in SECTION  
Allegan

(County)	Located in:	Corner Code #
1. Public Land Survey	T <sup>4N</sup> R <sup>12 W</sup>	D-9 (North 1/4 29) Dorr Twp.
2. Property Controlling in Section	T R	
3. Miscellaneous Property in Sec.	T R	
	S T R	
	S T R	
	S T R	
	S T R	


*Joyce A. Scott*  
REGISTER OF DEEDS  
ALLEGAN COUNTY, MICH.  
Register of Deeds Stamp & File Number

1100007 PAGE 26

4. Lot No. \_\_\_\_\_, Recorded Plat \_\_\_\_\_  
5. Private Claims \_\_\_\_\_

Steven Koerber June 4 99

I, \_\_\_\_\_, in a field survey on \_\_\_\_\_, 19\_\_\_\_ do hereby state that under requirements of P.A. 74, Michigan P.A. of 1970, the corner points mentioned in lines 1 and 2 above were in conformance with regulations and rules therefore as required in the current manual of survey instructions of the United States Department of the Interior, Bureau of Land Management or by a decree of a Court of Law and/or that the corner points mentioned in lines 3, 4 and 5 above were in conformance with the rules of the Michigan Board of Land Surveyors or by a Decree of a Court of Law; established, re-established, monumented, recovered, found as expressed below:

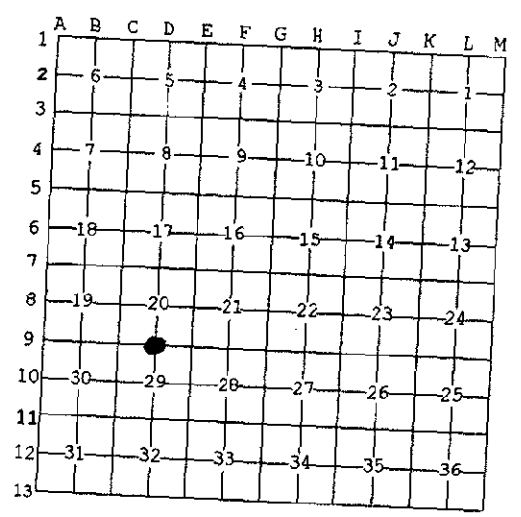

NOTE: Not more than 2 corners, all in the same town and range, may be recorded on this certificate.

A. Description of original monument and accessories and/or subsequent restoration:

- D-9 GLO - L. Lyons DS 1831 1. J.W. Hicks March 1876
  - Pine 30 S3E 12 Stone
  - Beech 10 S61E 6 Pine 16" SE 41
  - Tree 8 NE 21
2. Section breakdown notes from old Co. Surv.  
Dist from D-9 to D-10 2687.14'  
Second dist on card D-9 to D-10 2689.64'

(Additional info. on back of sheet)


B. Description of corner evidence found and/or method applied in restoring or reestablishing corner:

- D-9 Found 3/4" solid iron
  - 20" Maple NE 28.1'
  - 16" Maple ESE 67.15'
  - TP SE 44.2'
  - USC&GS BM W 46.5'
  - PP W. 48.25'
  - St. sign West 21.4'
- This corner is accepted as a careful and faithful perpetuation of the position of the original corner.  
Peer Group approval June 8, 1999.  
Dist to D-10 = 2689.36'

C. Description of monument for corner and accessories established to perpetuate locating the position of the corner:

- D-9 Set Standard Allegan Co. Mon. ( 3/4" x 24" Iron Rod with Remon. cap)
- Set nail & Allegan Co. Remon. tag in N. side 18" Oak S55E 37.70'
- Set nail & Allegan Co. Remon. tag in N. side P.Pole N90W 48.58'
- Set nail & Allegan Co. Remon. tag in SE side 24" Pine N70E 61.03'
- Set nail & Allegan Co. Remon. tag in S. side 16" Cherry S65W 55.27'

APPROVED REMONUMENTATION CORNER  
P.A. 345 OF 1990  
ALLEGAN COUNTY  
DATE APPROVED JUNE 8, 1999  
COUNTY REP. [Signature]

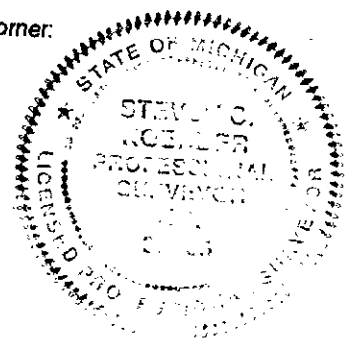

Signed by [Signature]  
Surveyor's Michigan License No. 39085

Date 8-10-1999

D-9 DORR TWP.

RE... & ...

MAR 07 2000

SECTION

LIBERO 007 PAGE 2 27

- 3. March 1914  
Co. Drain notes  
C/L Drain 100.7 rods West of N 1/4 corner  
C/I Drain 27.78 rods South of N1/4 corner
- 4. Old note card from Wightman office  
20" Maple NE 28.1'  
16" Maple ESE 67.15'  
TP SE 44.2'  
USC&GS BM W 46.5'  
PP W. 48.25'  
St. sign West 21.4'
- 5. Witness note sheet - Holland Eng.  
Fnd. 2" IP- set spike inside  
Tele Pole NE 53.51'  
24" Maple ESE 65.54'  
Tele Pole SE 37.84'  
PP West 48.39'  
C/L Street sign West 22.12'      Note: Found "T" iron 3.80 South, 1.80 East - bent
- 6. 7-29-1971  
L.C.R.C. L 1. Pg. 91 (Allegan Co.)  
Donald Ratekin  
Found 3/4" iron - bent    Reset 1" iron pin  
Same wits as No. 4 above
- 7. 7-9-1971  
Act 132 survey Donald Ratekin  
Same wits as No. 4 above
- 8. 10-30-1973  
L.C.R.C. L.2, Pg.162  
Donald Ratekin  
Same wits as No. 4 above
- 9. 5-22-1973  
Act 132 survey Donald Ratekin  
Same wits as No. 4 above
- 10. 7-12-1974  
L.C.R.C. L.2, Pg.316  
John Clapp  
Same wits as No.5 above
- 11. 12-29-1976  
Act 132 survey John Clapp  
Same wits as No. 5 above
- 12. 3-23-1977  
Act 132 survey Donald Ratekin  
Same wits as No. 4 above
- 13. 3-30-1978  
Act 132 survey Gordon Nederveld L. 971, Pg. 210-211  
1" solid iron  
Spike on E'ly side 26" Maple NNE 29.07'  
PK on N. side P.Pole W-SW 48.52'  
Spike on W. side 24" Maple ESE 67.9'
- 14. 5-11-1979  
Act 132 survey Exxel Eng  
Douglas Bonnema  
Same wits as No. 4 above
- 15. 3-5-1980  
Act 132 survey Medema Van Kooten & Assoc. L. 992, Pg. 754  
3/4" Rod  
PK nail in P.Pole West 48.50'  
Spike in 26" Maple NNE 24.04'  
Spike in 24" Maple ESE 67.88'  
Spike in 16" Sass. SSE 46.40'
- 16. 1996  
Nederveld & Assoc.  
Fnd and held 3/4" solid iron  
Fnd. PK nail in N. side P.Pole S84W 48.25'  
Fnd. Nail West side 20" Maple S75E 66.97'  
Set PK nail SE side 24" White Pine N65E 61.00'  
Set PK nail in NW side 15" Cherry S60W 54.62'